


T.23S.R.31E.W.M.

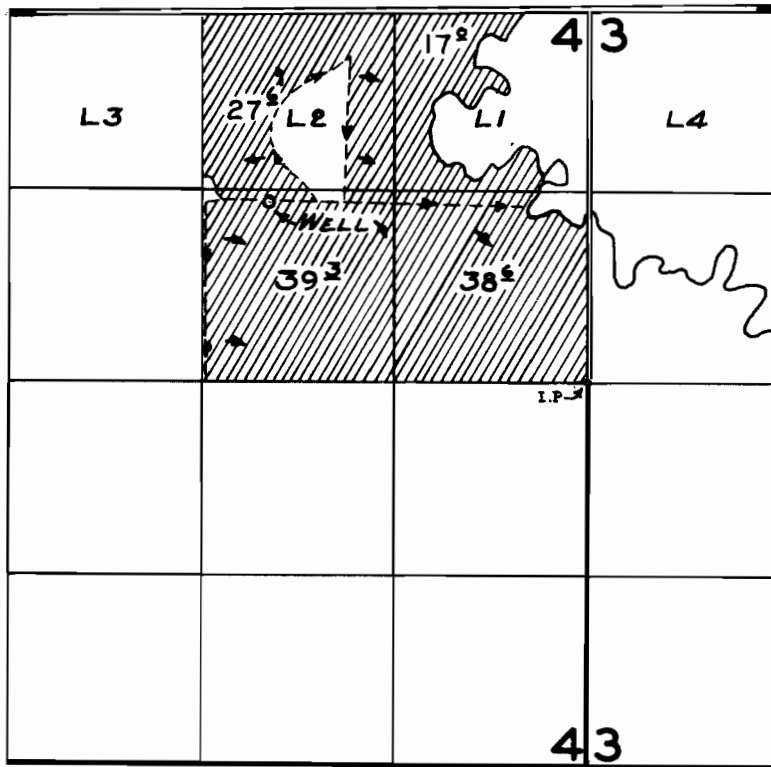

FINAL PROOF SURVEY

UNDER

Application No. G-759 Permit No. G-699
IN NAME OF

.....LOLA TYLER/LESTER TYLER.....

Surveyed Oct. 21 1960, by

EFI-1V-196