


T.22S.R.32E.W.M.

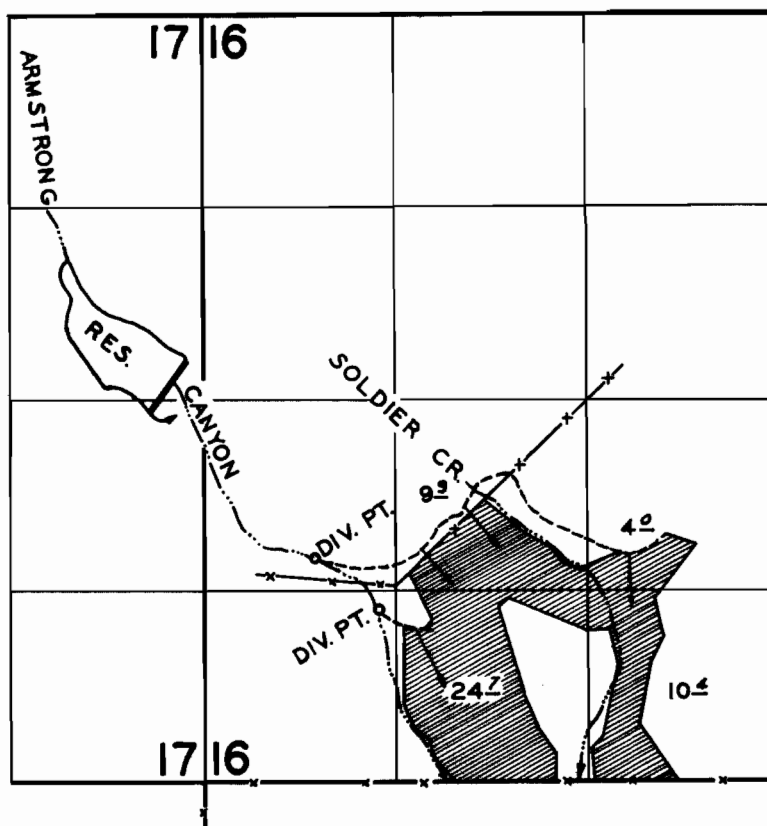

FINAL PROOF SURVEY
UNDER

Application No. R 28898 Permit No. R 1566
28899 22631
IN NAME OF

G. N. JAMESON

Surveyed OCT. 27, 1960, by C. O. BARTELS