


T.3N.R.10E.W.M.

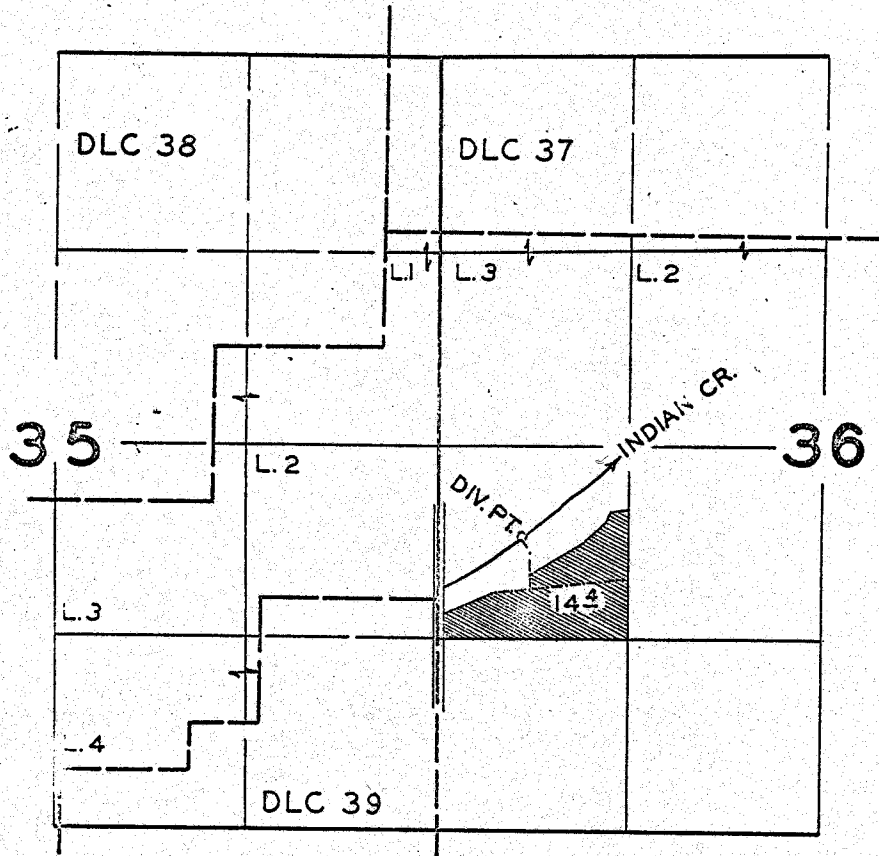

FINAL PROOF SURVEY UNDER

Application No. 24447... Permit No. 19274.....
IN NAME OF

Elmer B. Clark & Virginia M. Robinson

Surveyed NOV. 2... 1960., by C. O. BARTELS...