


19 20
30 29

T. 36 S., R. 2 W., W.M.

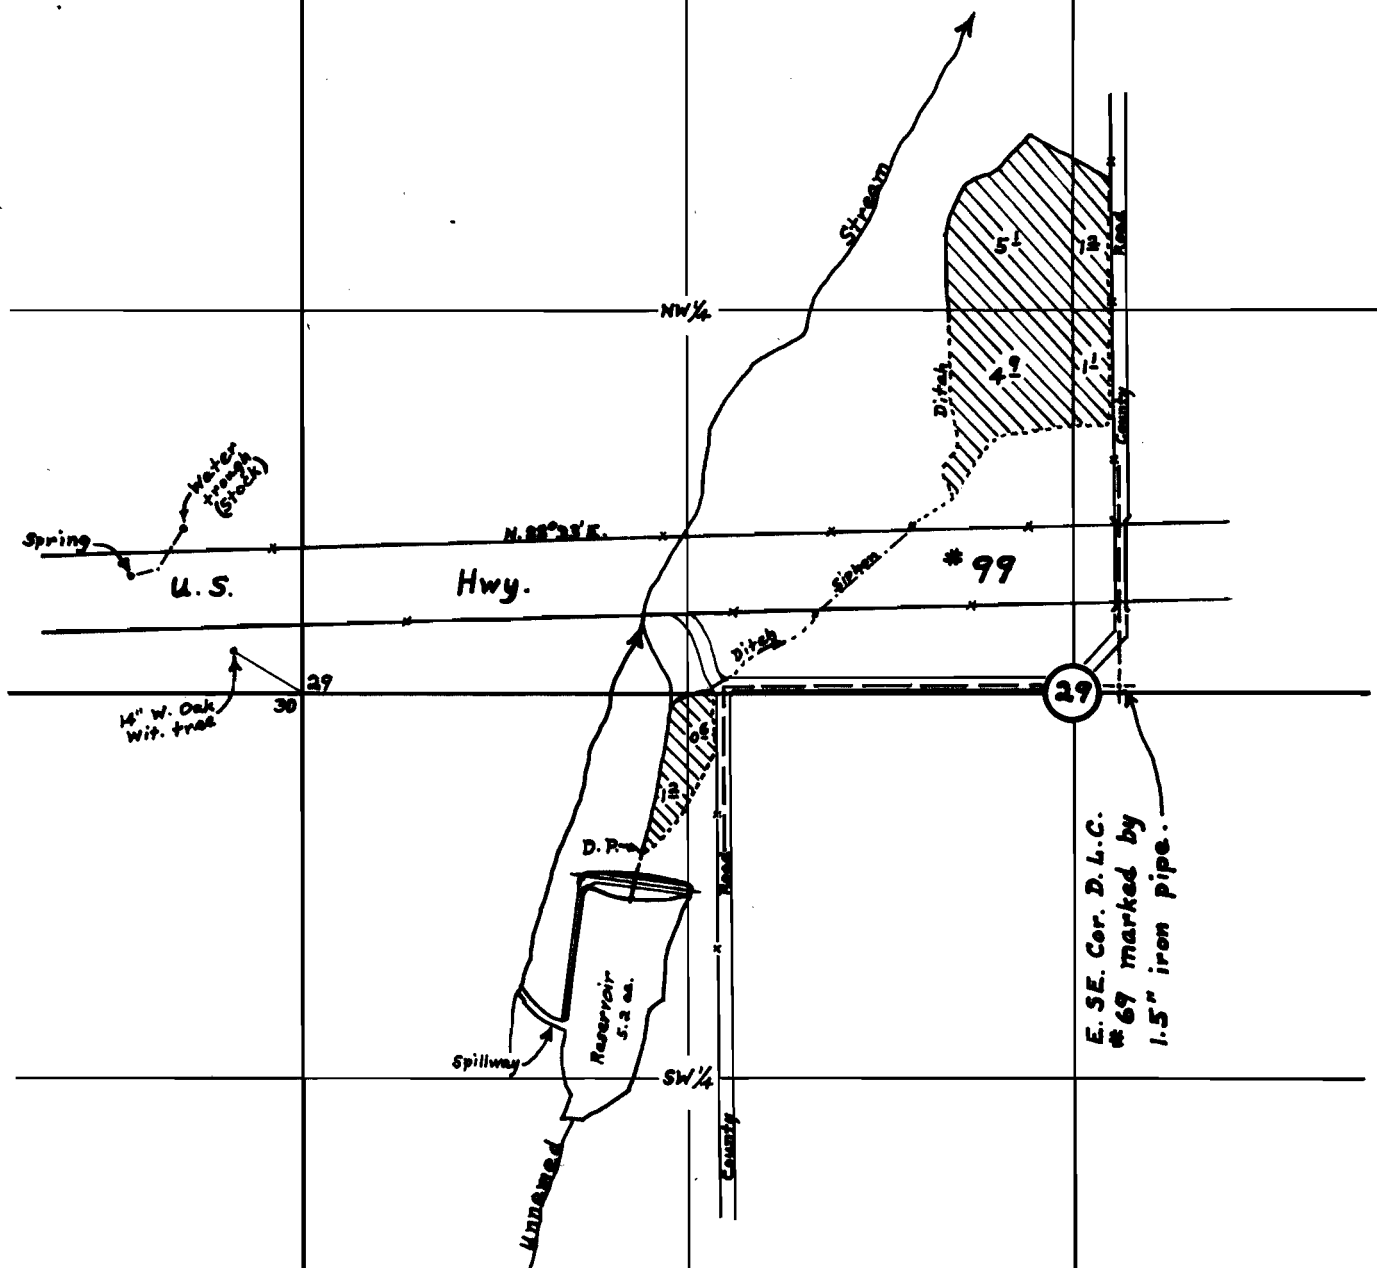

FINAL PROOF SURVEY
UNDER

Application No. R-27447 Permit No. R-1398
27448 21609
IN NAME OF

A. W. McCormick

Surveyed March 21, 1961, by D. L. Hendrix

Scale: 8" = 1 mile

Plane Table Survey