


# T. 37 S. R. 1 E. W. M.

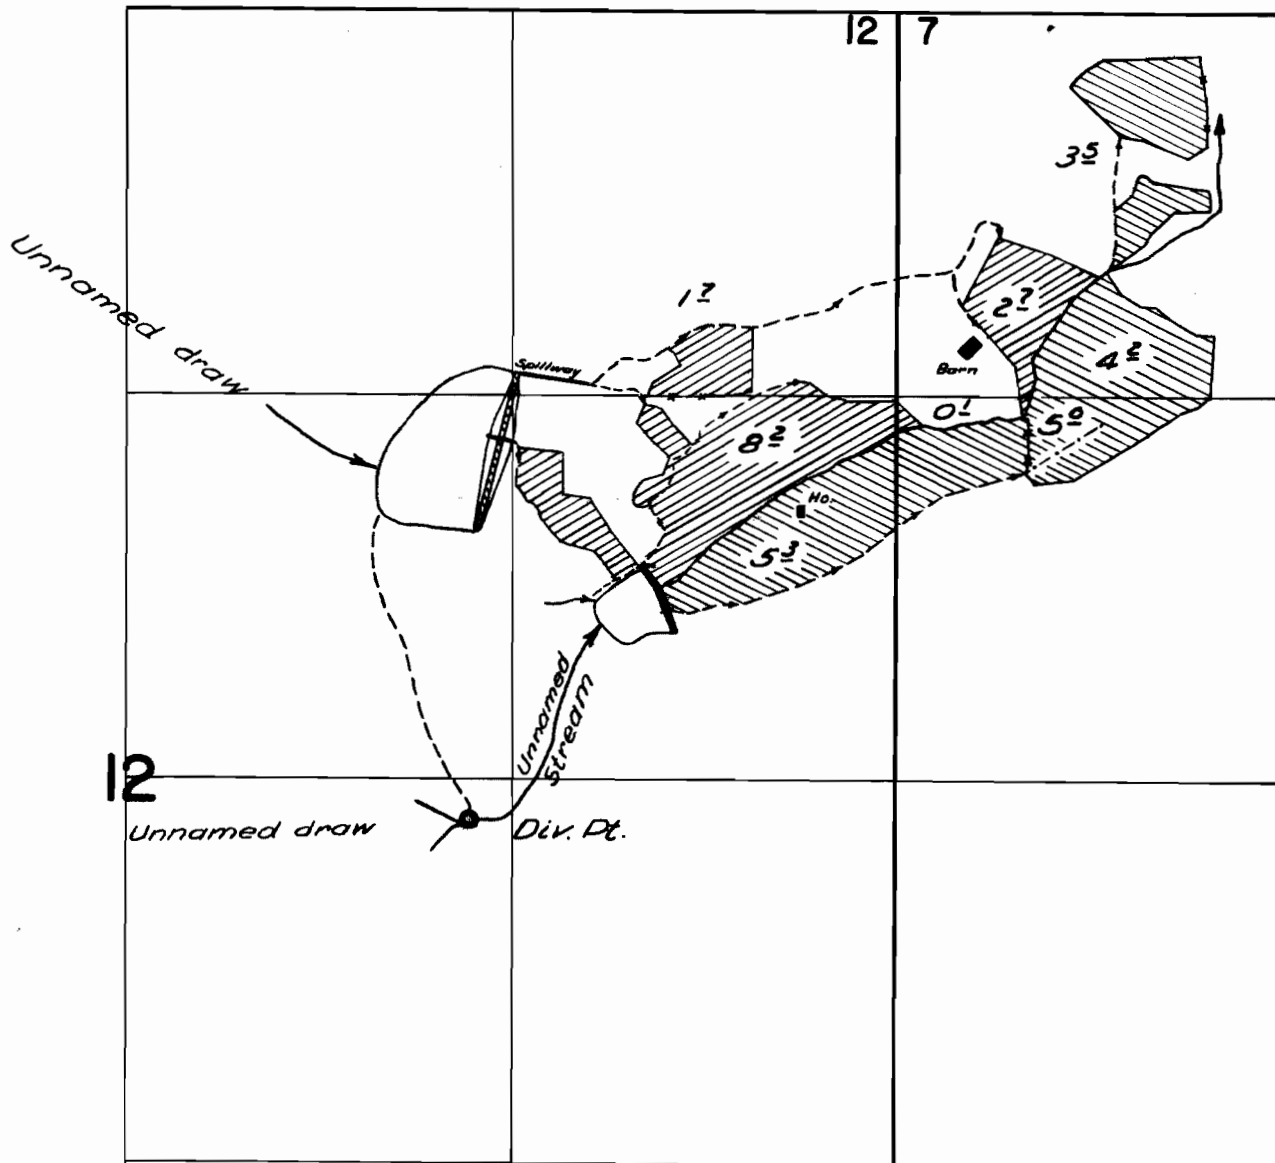

## FINAL PROOF SURVEY

UNDER

R-24159  
24160  
R-28715  
28716  
R-28865  
28866

R-995  
19007  
R-1557  
22608  
R-1563  
22628

Application No. 28866 Permit No. 22628  
IN NAME OF

**CARL W. NYGREN**

Surveyed 5 APRIL 1960, by *M. C. Bish*  
16 MAY 1959 C. O. BARTELS  
DAVID HENDRIX