


T. 37 S. R. 1 E. W. M.

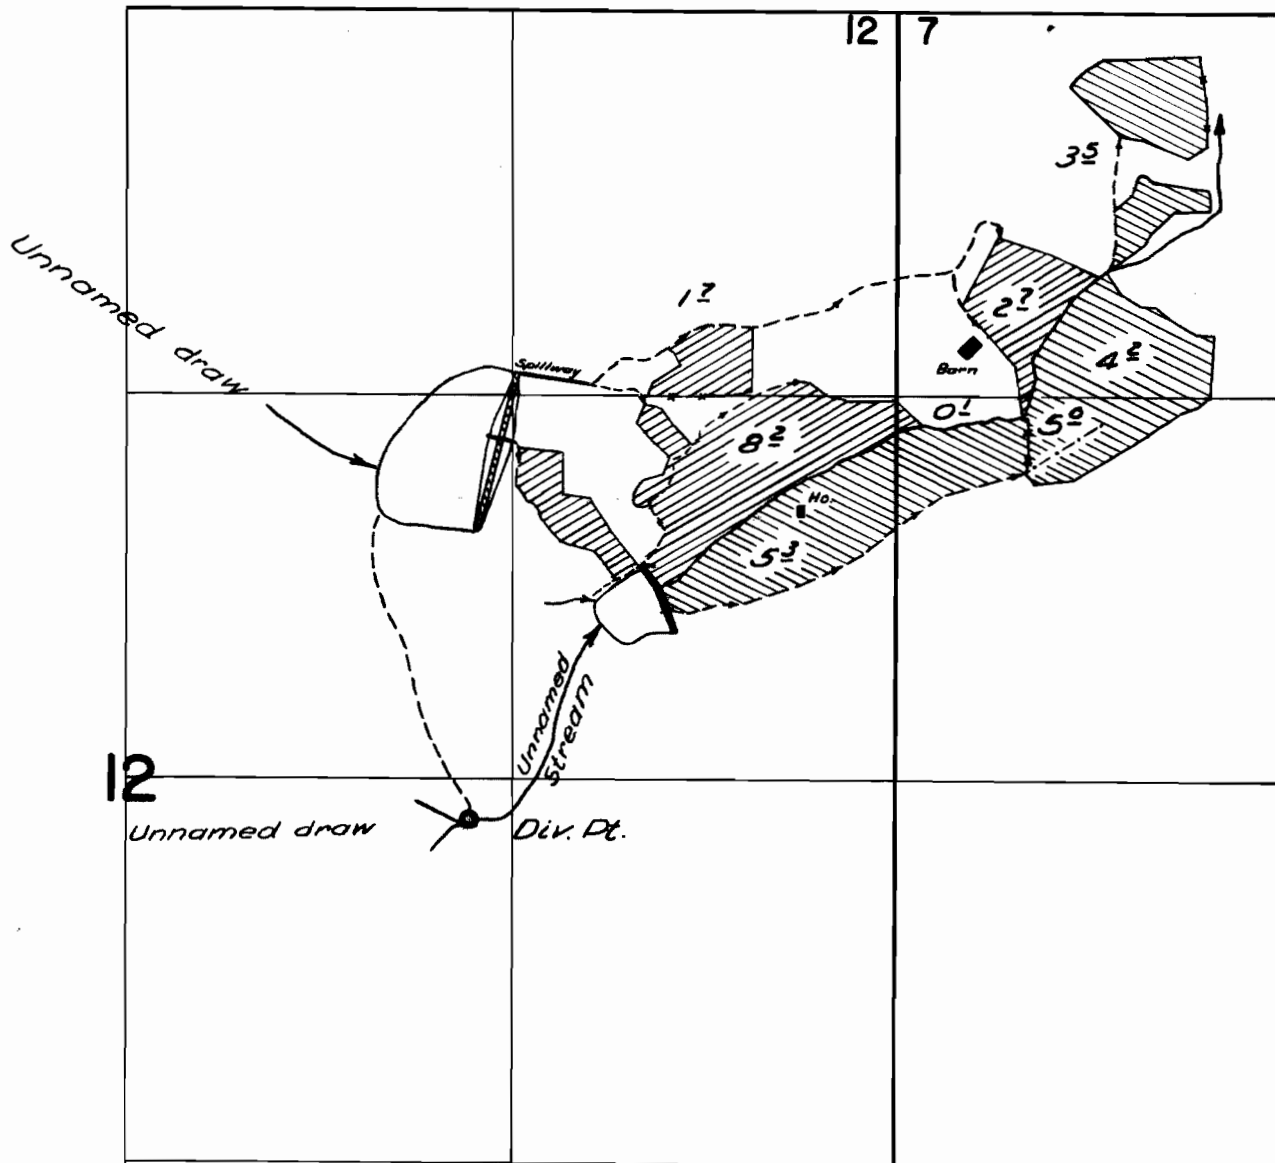

FINAL PROOF SURVEY

UNDER

R-24159
24160
R-28715
28716
R-28865
28866

R-995
19007
R-1557
22608
R-1563
22628

Application No. 28866 Permit No. 22628
IN NAME OF

CARL W. NYGREN

Surveyed 5 APRIL 1960, by *M. C. Bish*
16 MAY 1959 C. O. BARTELS
DAVID HENDRIX