


T. 36 S., R. 3 W., W.M.

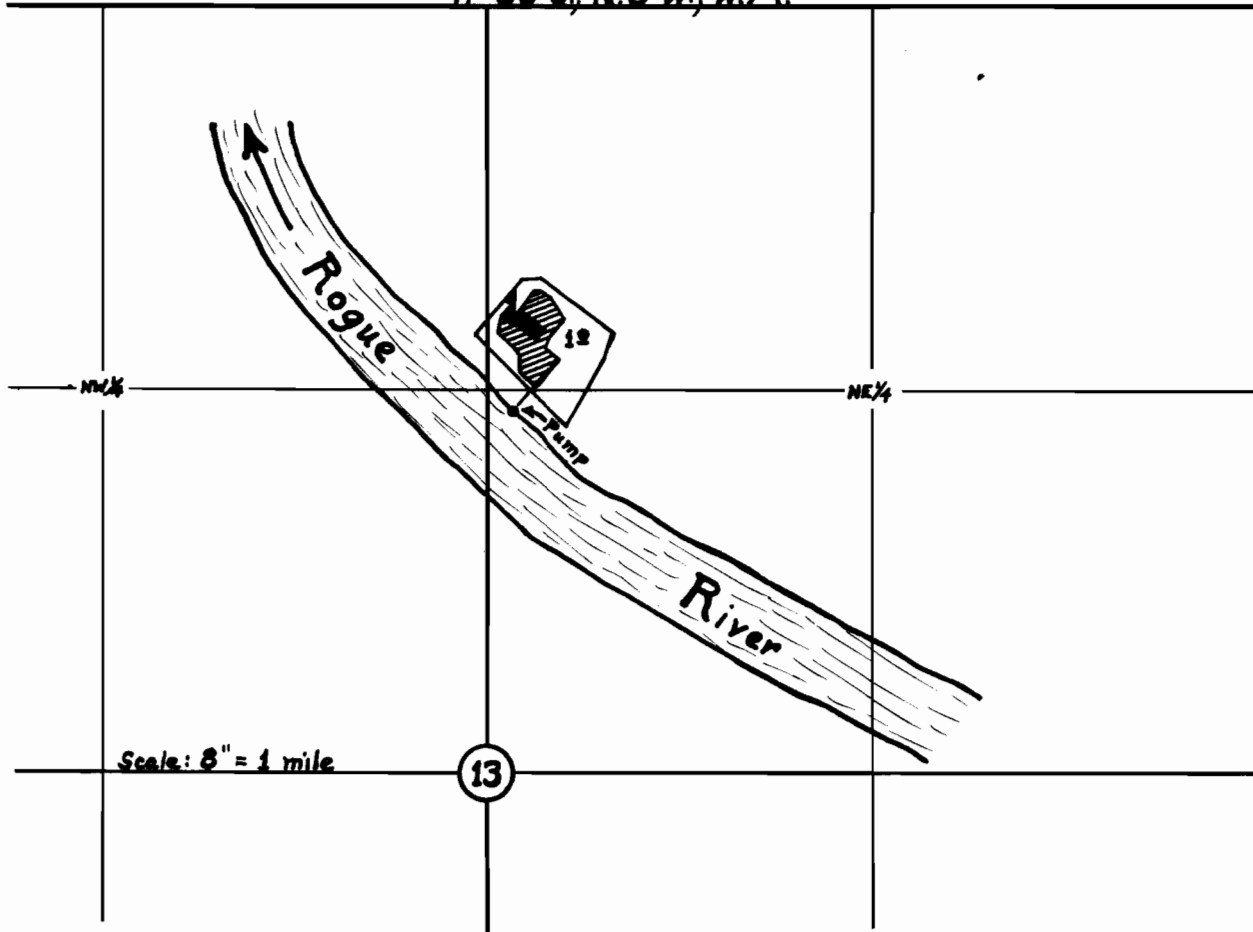

**FINAL PROOF SURVEY**  
UNDER

Application No. 30039 Permit No. 23685  
IN NAME OF

.....Robert J. Wells.....

Surveyed March 28 1961, by D. L. Hendrix

**RECEIVED**  
APR. 5 1961  
STATE ENGINEER  
DALE S. GARDNER