


T.39S.R.5W.W.M.

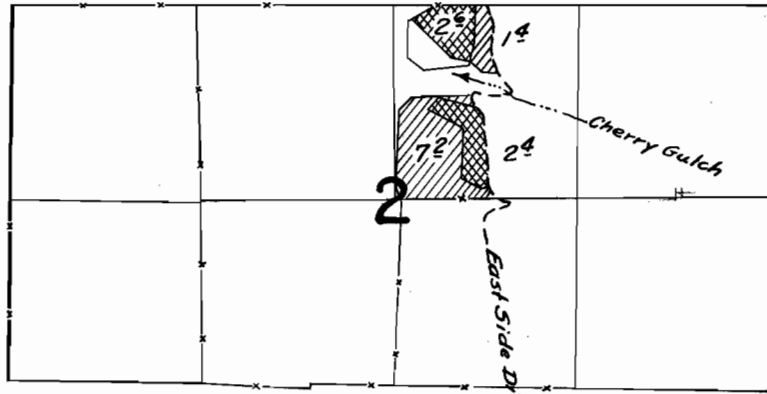

 Supplemental  Primary



FINAL PROOF SURVEY
UNDER

Application No. 17958... Permit No. 13636...
IN NAME OF

CLAIR O. BROWN

Surveyed *Sept. 29* 1960, by *R. Steimer*...