


T.37&38S.R.8W.W.M.

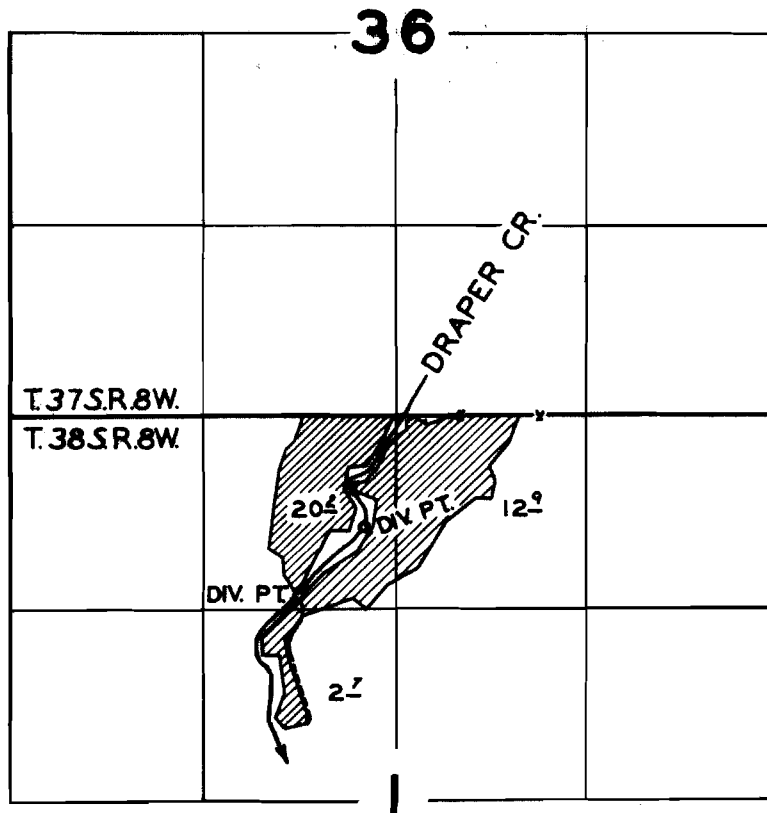

**FINAL PROOF SURVEY
UNDER**

Application No. 24222.... Permit No. 19031.....
IN NAME OF

.....**L. W. ARCHER**.....

Surveyed OCT. 4... 1960., by R. B. STEIMER...