


T.35S.R.6W.W.M.

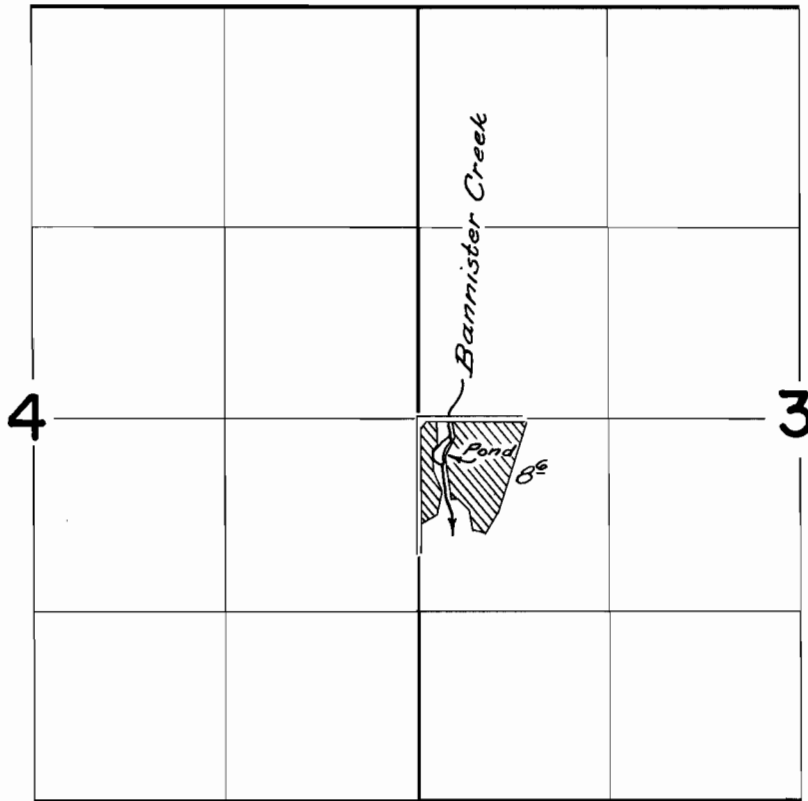

**FINAL PROOF SURVEY**  
UNDER

Application No. 25029 Permit No. 19718  
IN NAME OF

MR. & MRS. ROBERT E. HAUSE

Surveyed Sept. 27, 1960, by C.O. Bartels