


T.35S.R.6W.W.M.

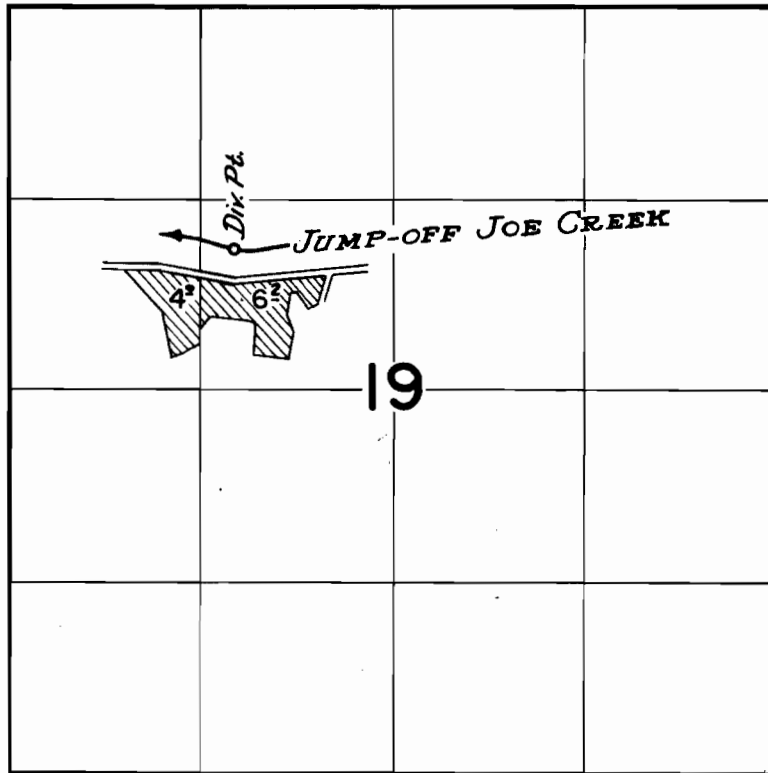

FINAL PROOF SURVEY
UNDER

Application No. 29915..... Permit No. 23549....
IN NAME OF

.....GLADYS O. GIBSON.....

Surveyed Sept. 30. 1960, by R. Steimer.....