


T.38S.R.7W.W.M.

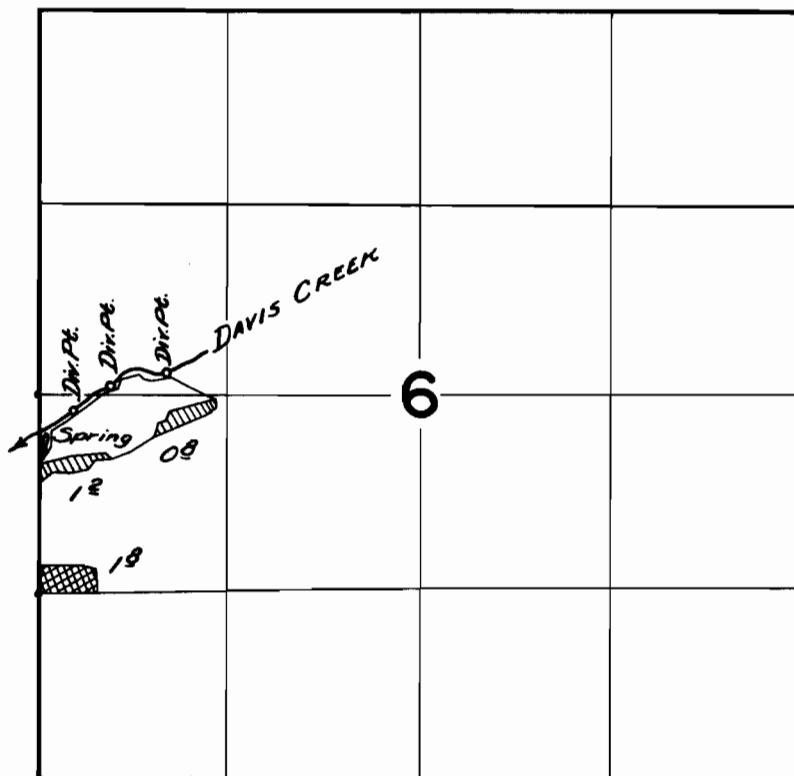

FINAL PROOF SURVEY
UNDER

Application No. 29986 32669 Permit No. 23619 25928
IN NAME OF

Arthur A. & Ruth O. Whitesell

Surveyed Sept. 28, 1960, by R. Stejmar.....