


T.38 S.R.8 W.W.M.

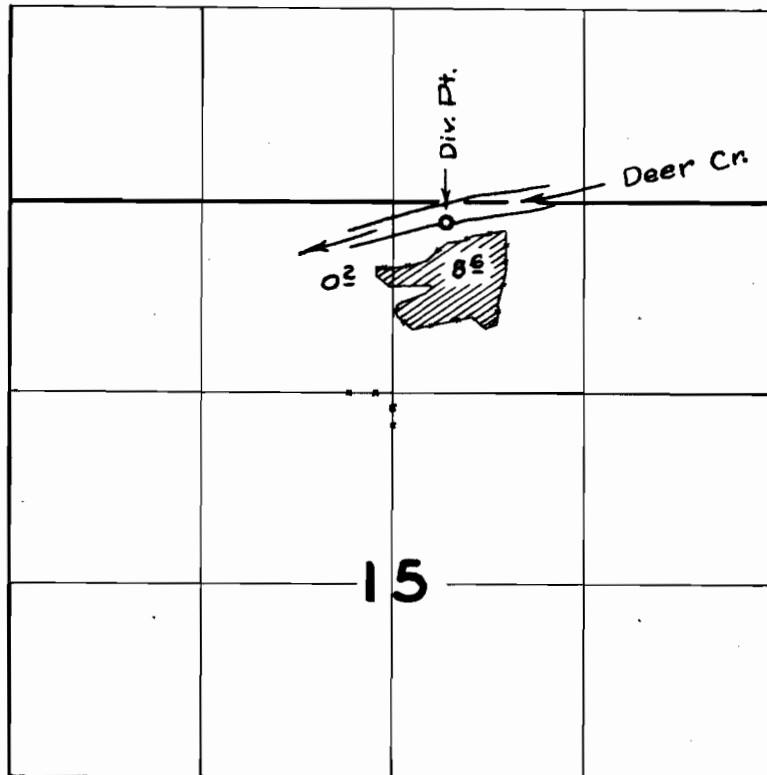

FINAL PROOF SURVEY
UNDER

Application No. 30211 Permit No. 23820
IN NAME OF

M. A. SPRAGUE

Surveyed 18 July 1959, by T. B. Buel