


T.38S.R.7W.W.M.

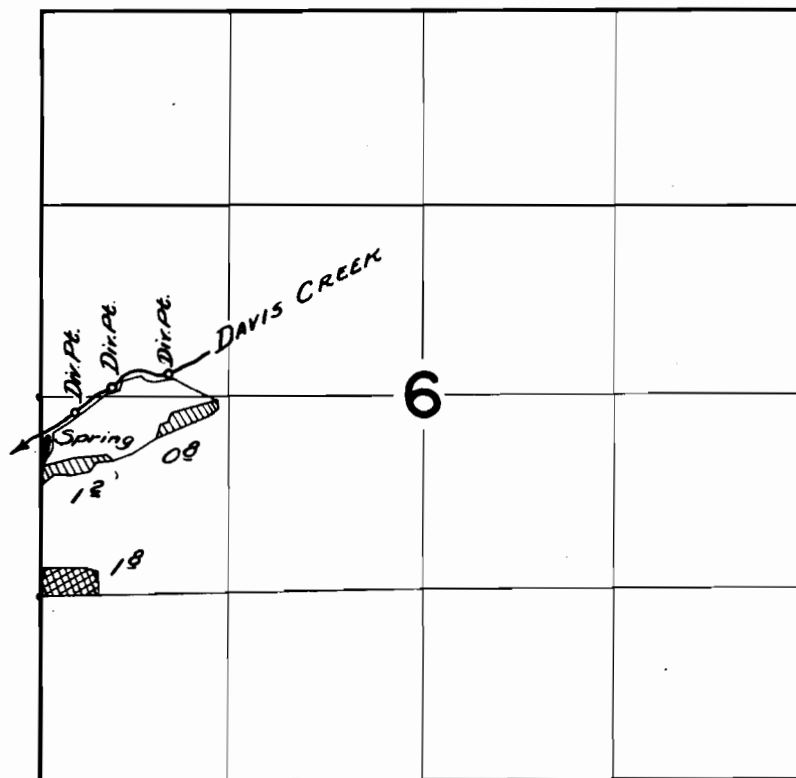

FINAL PROOF SURVEY
UNDER

Application No. **29986** Permit No. **23619** 
32669 **25928** 
IN NAME OF

Arthur A. & Ruth O. Whitesell

Surveyed Sept. 28 1960, by R. Steimer.....