


Per 3308
2848

Mason Ditch
John Mason.

Township 14 P.,
R. 30 E

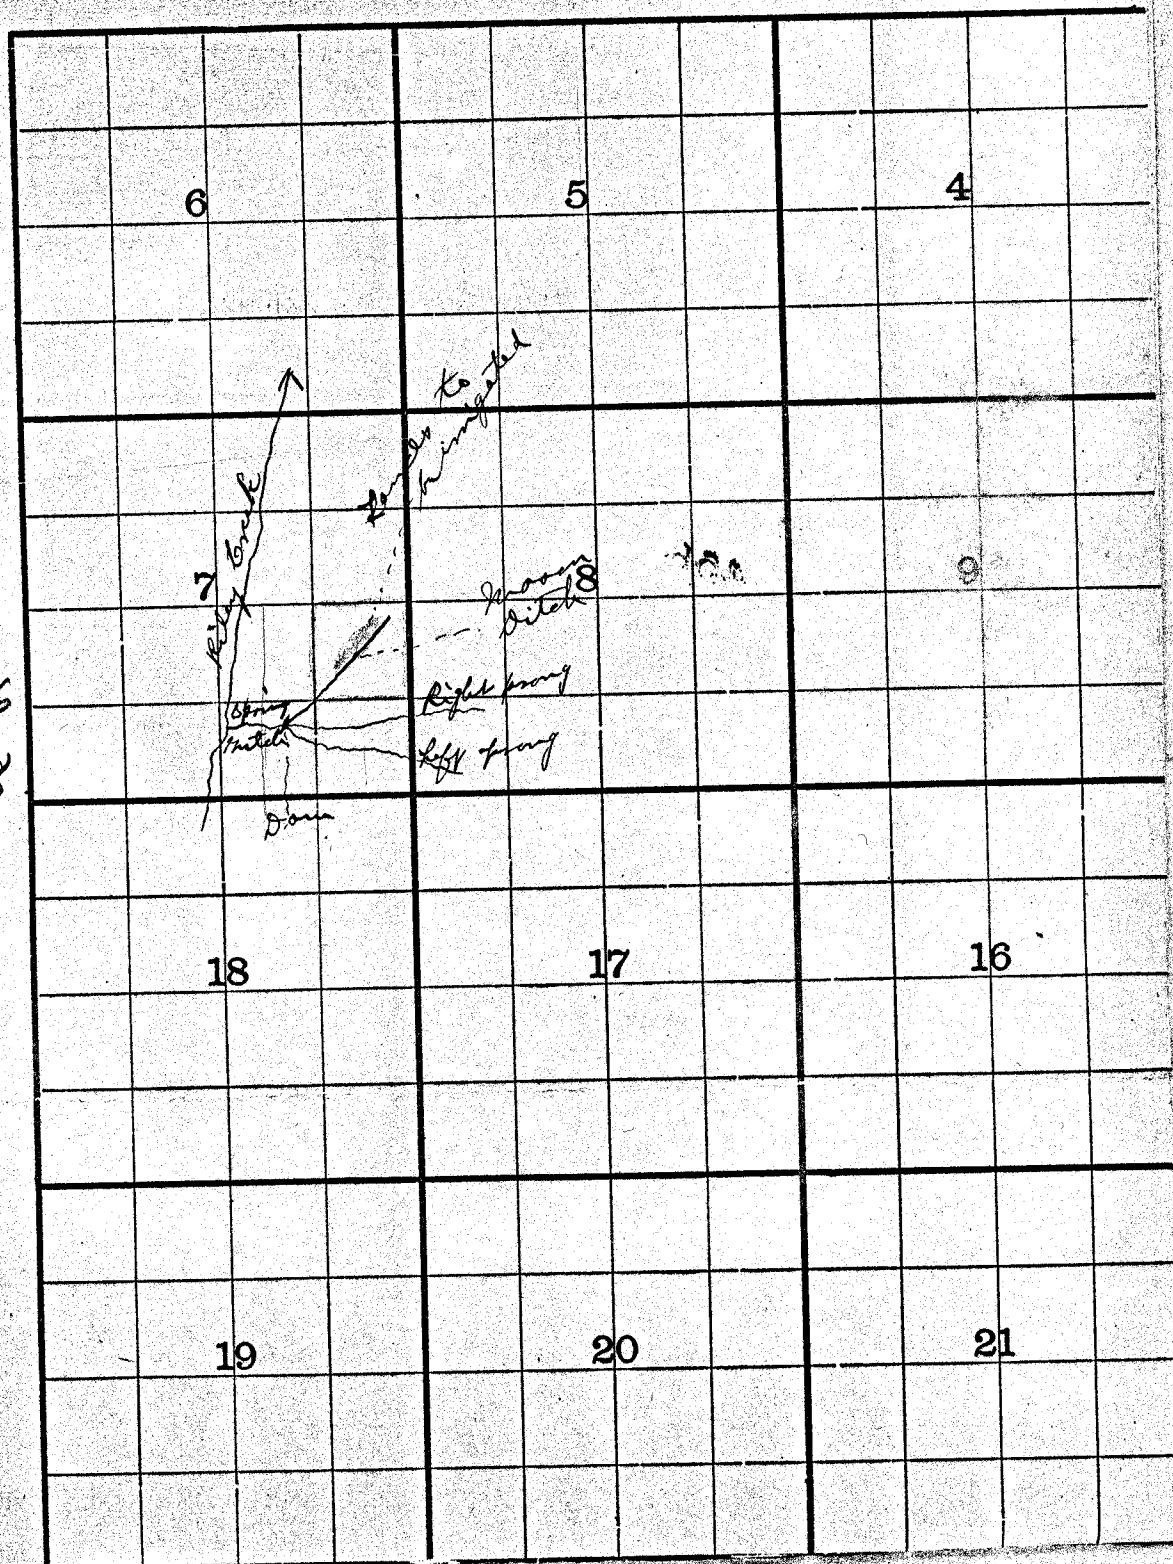

App 5456

Per 3308