

E. Br. Lost River : msc.

T.40 S.R.14 1/2 E.W.M.

28

FINAL PROOF SURVEY

UNDER


Transfer No. J-25

Application No. 28522 Permit No. 23921

IN NAME OF

STANLEY JOHNSON & JOHNSON STOCK CO.

Surveyed Oct. 7 & 8, 1959, by M. Bish

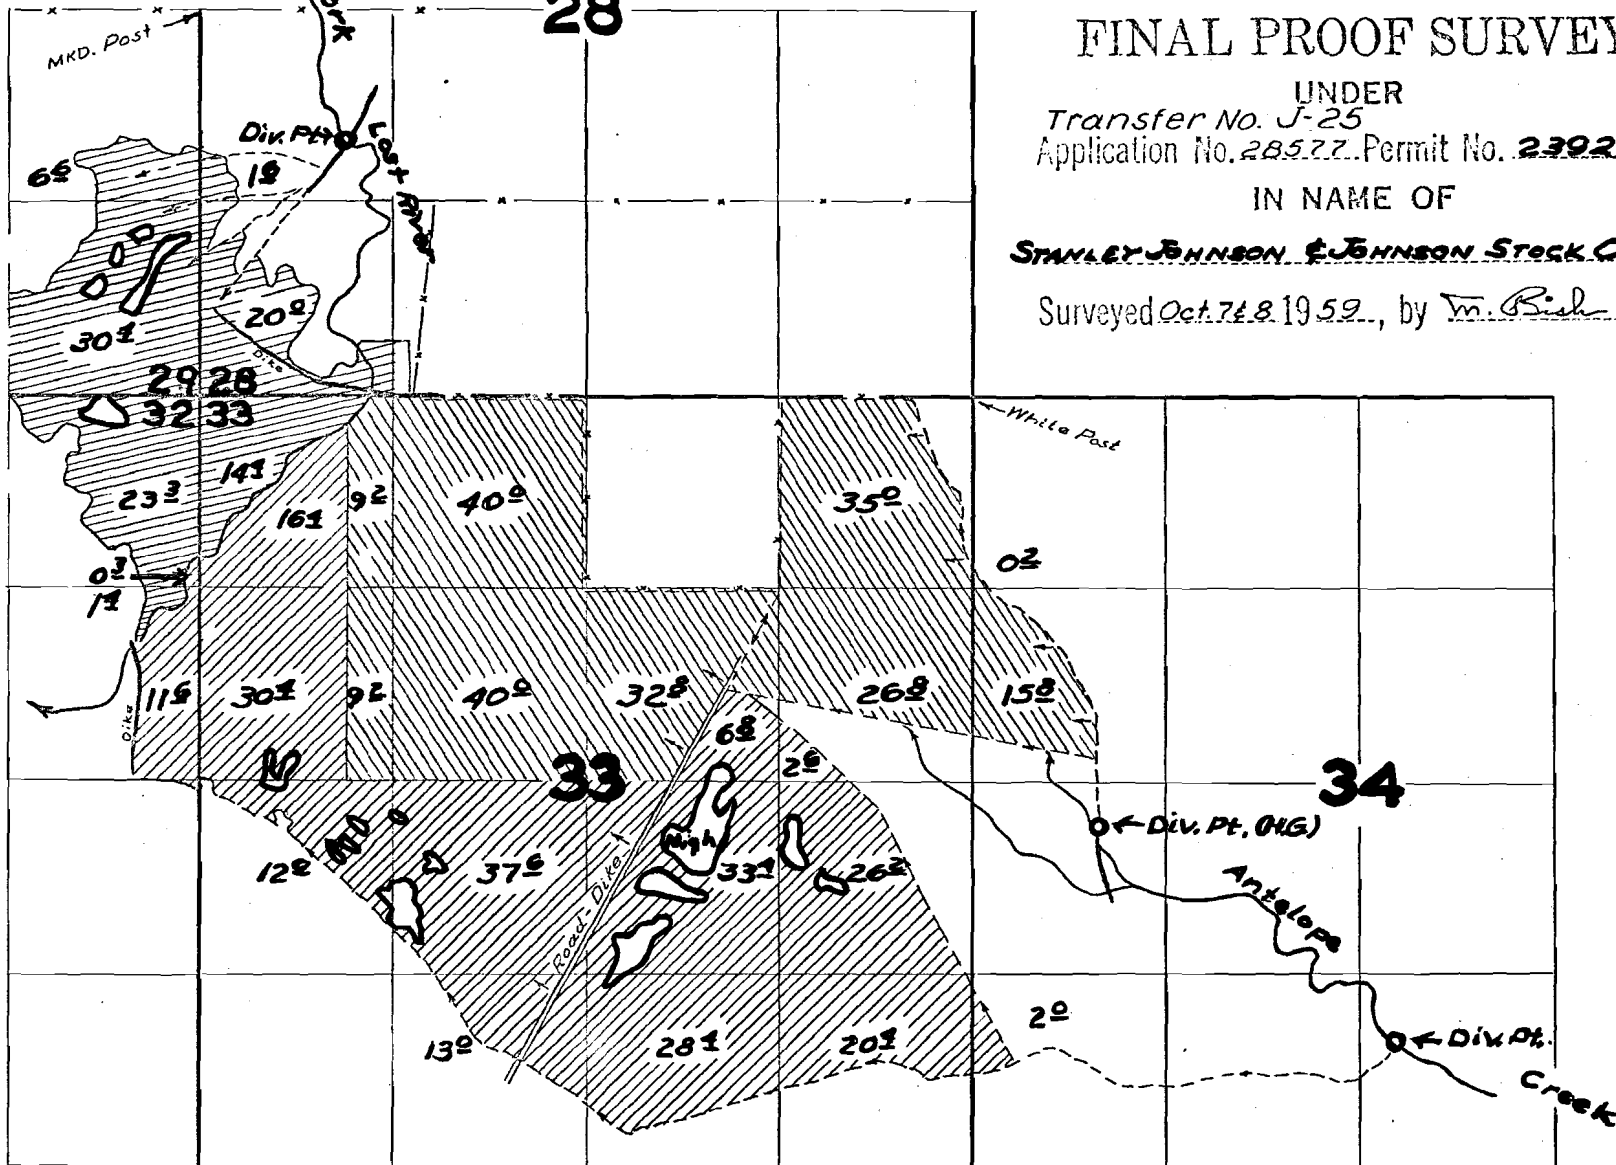

TRANSFER
N. FR. LOST RIVER
ANTELOPE CREEK

2 maps

23921
28521