


U-513
28682

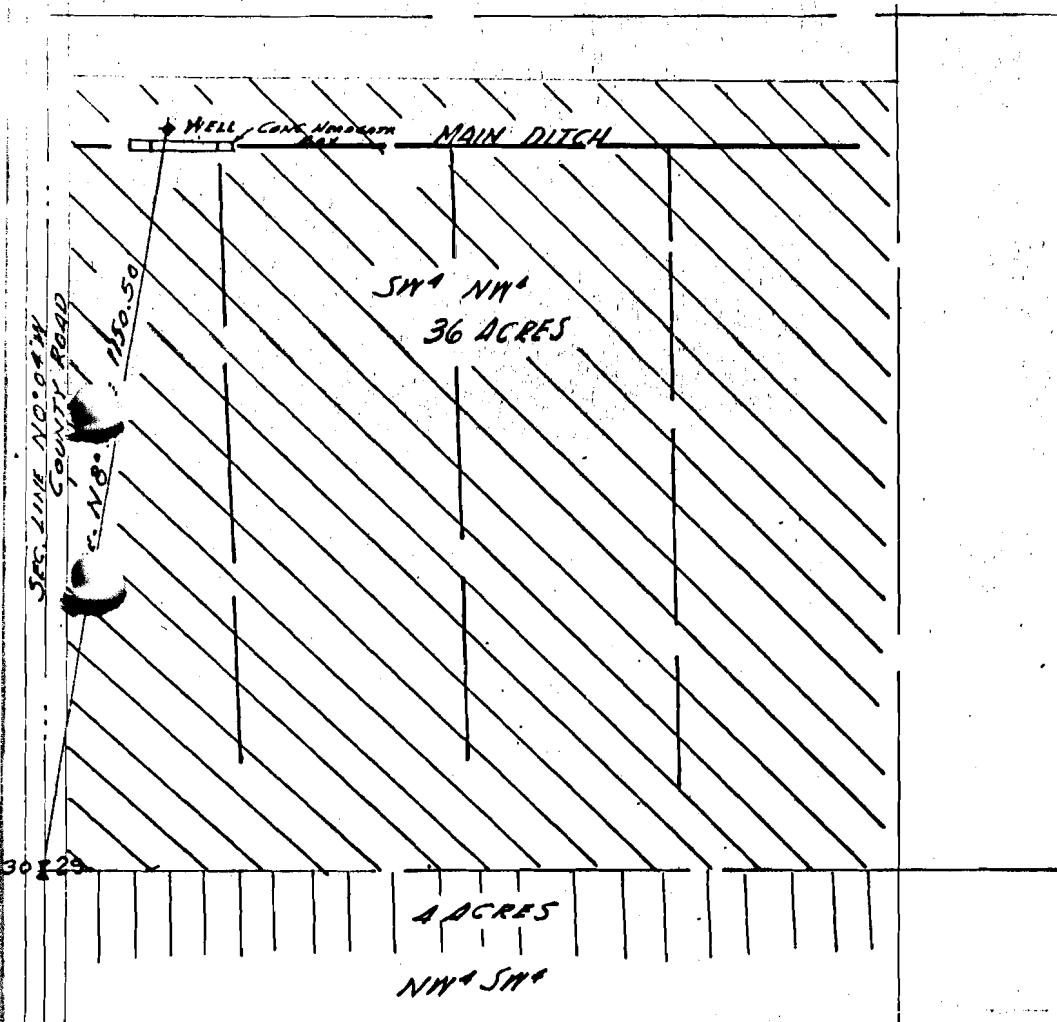

SCALE 1" = 300'

See Application
Map # G6870
filed under
Plainview Ranch
misc. Correspondence
Aug 1975

MAP TO ACCOMPANY THE APPLICATION OF
RICHARD SCHAUB OF FORT ROCK OREGON
TO APPROPRIATE UNDERGROUND WATERS
OF THE STATE, BY PUMPING, FOR
IRRIGATION PURPOSES.

REGISTERED
OREGON
LAND SURVEYOR

Glenn E. Tyler

NOV. 5, 1948
GLENN E. TYLER
250

I, GLENN E TYLER OF LAKEVIEW ORE. DO
HEREBY CERTIFY THAT THE ABOVE MAP
WAS MADE FROM FIELD NOTES TAKEN
DURING AN ACTUAL FIELD SURVEY MADE
BY ME ON FEB. 20 1953. THE CENTER
LINE OF THE WELL CASING IS N 8° 55' E 1150.50'
FROM THE WEST CORNER OF SECTION 29
T28S R15E N. 1/4

T 28 S R 15 E

Glenn E. Tyler

RECEIVED
MAR 10 1953
STATE ENGINEER

Application No. U-509
Permit No. U-513