


15338

28683

T.39S. R. 20E.W.M.

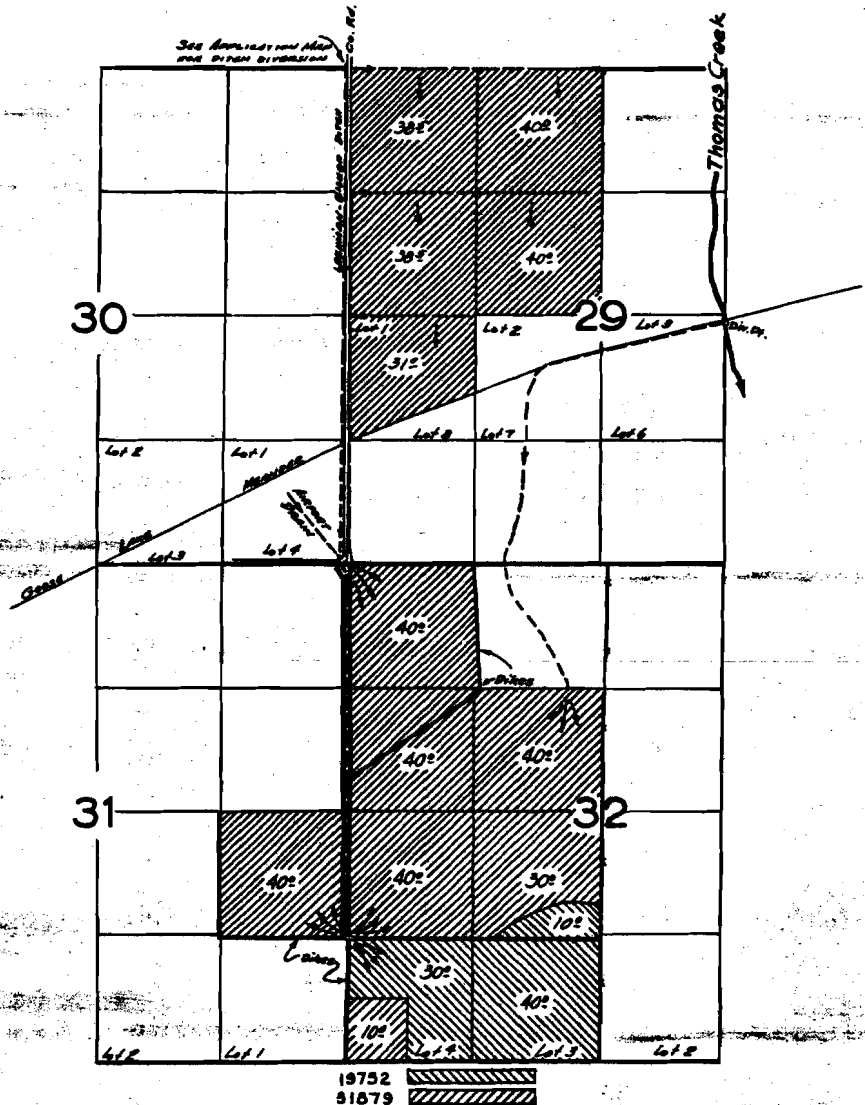

FINAL PROOF SURVEY

UNDER

Application No. 19752 Permit No. 15338
31879 25279

IN NAME OF

Surveyed May 12 1959, by P. Jackson