


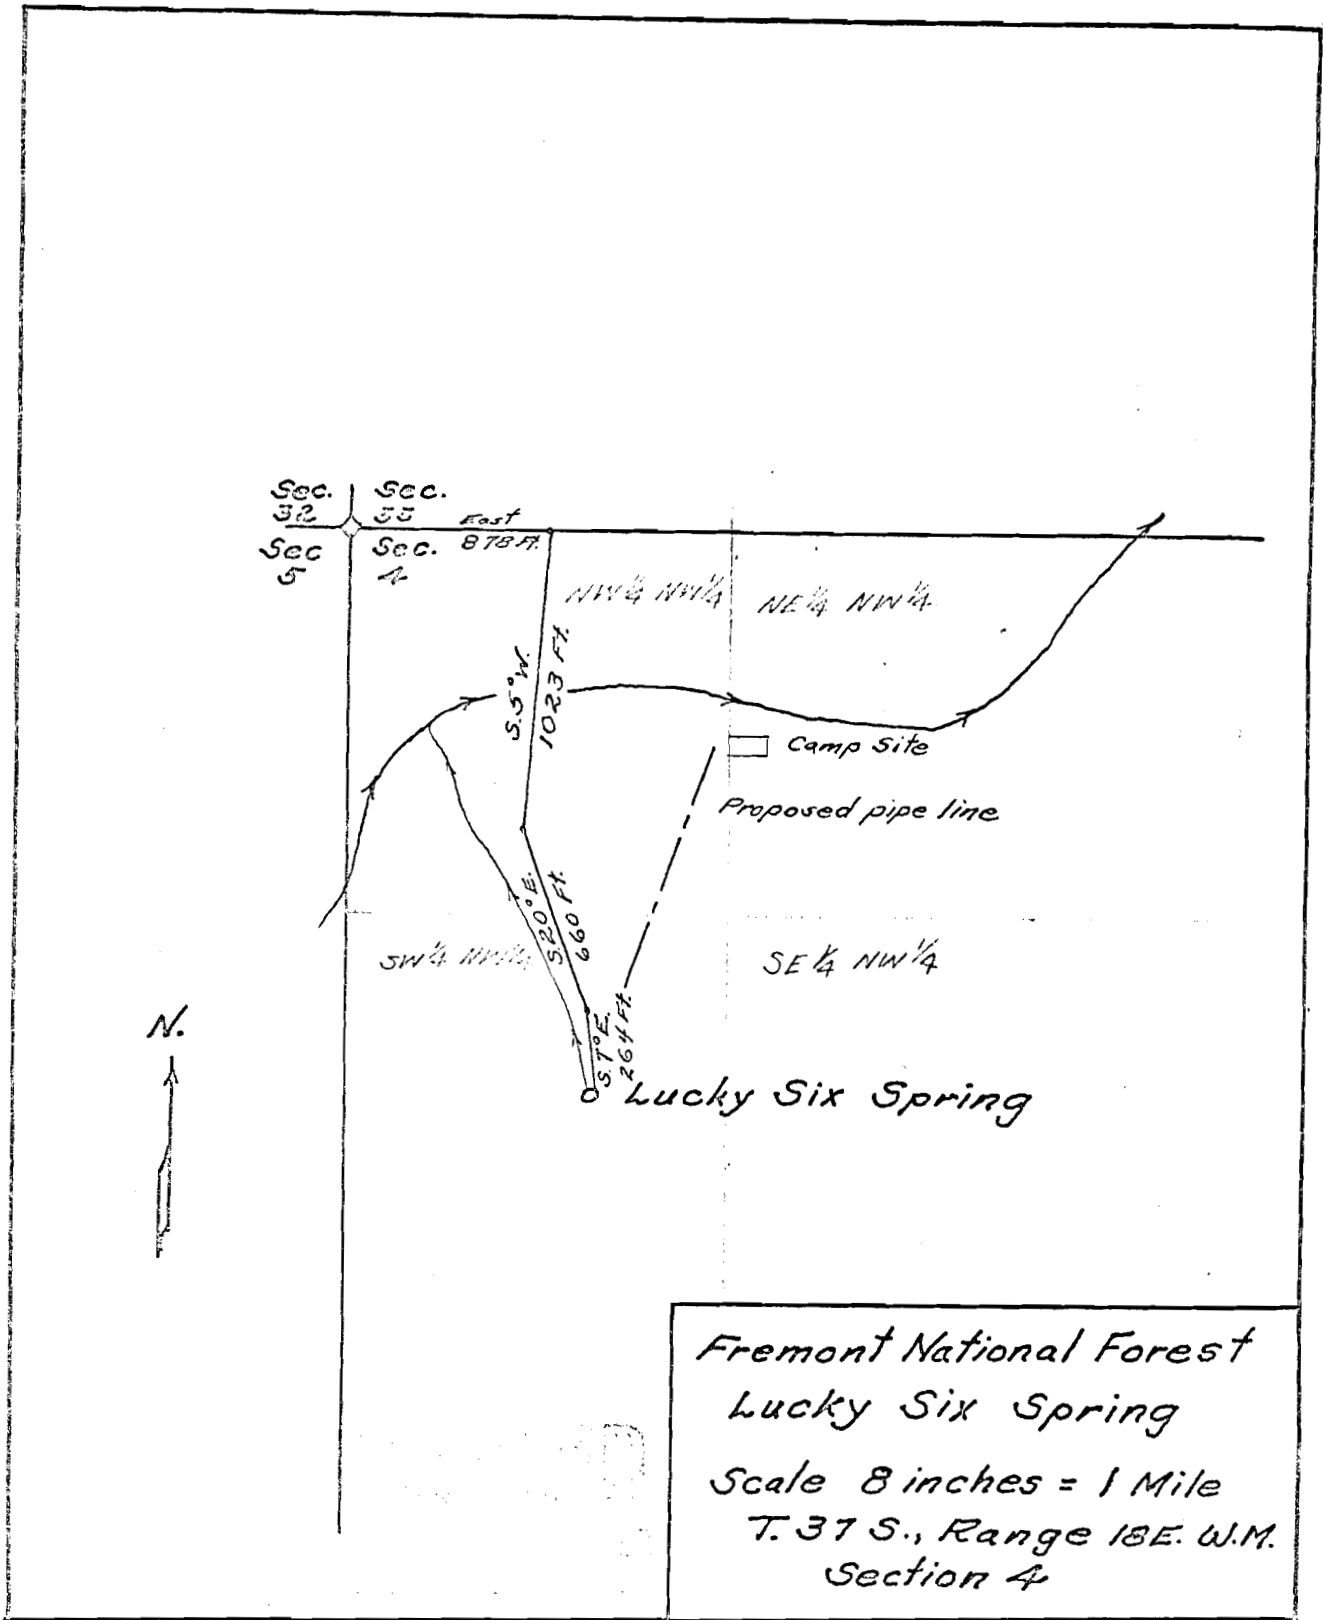

Locality No. 30603
Point No. 24115
37-18 ✓