


T.16S.R.3W.W.M.

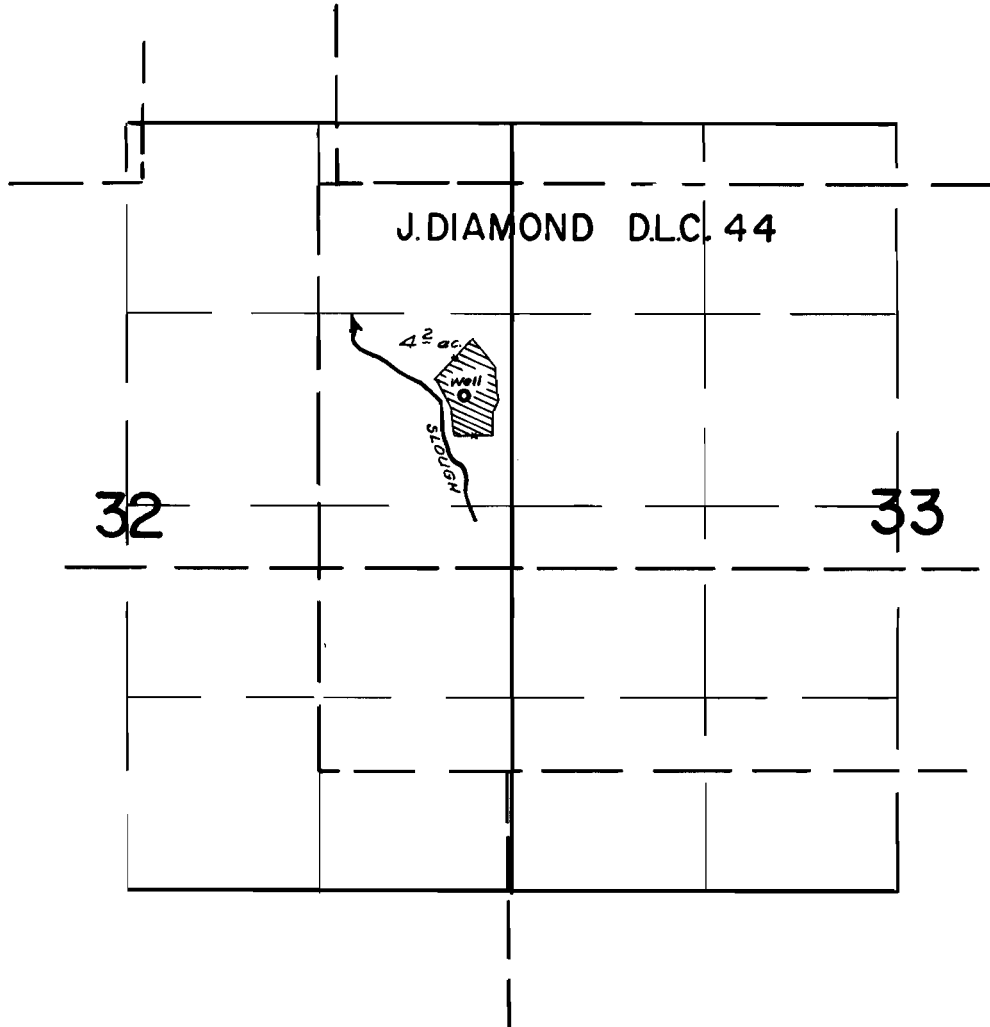

FINAL PROOF SURVEY
UNDER

Application No. G-624 Permit No. G-512
IN NAME OF

FRED W. LANZ

Surveyed 28 APRIL 1960, by Mr. Bish