


T.16S.R.3W.W.M.

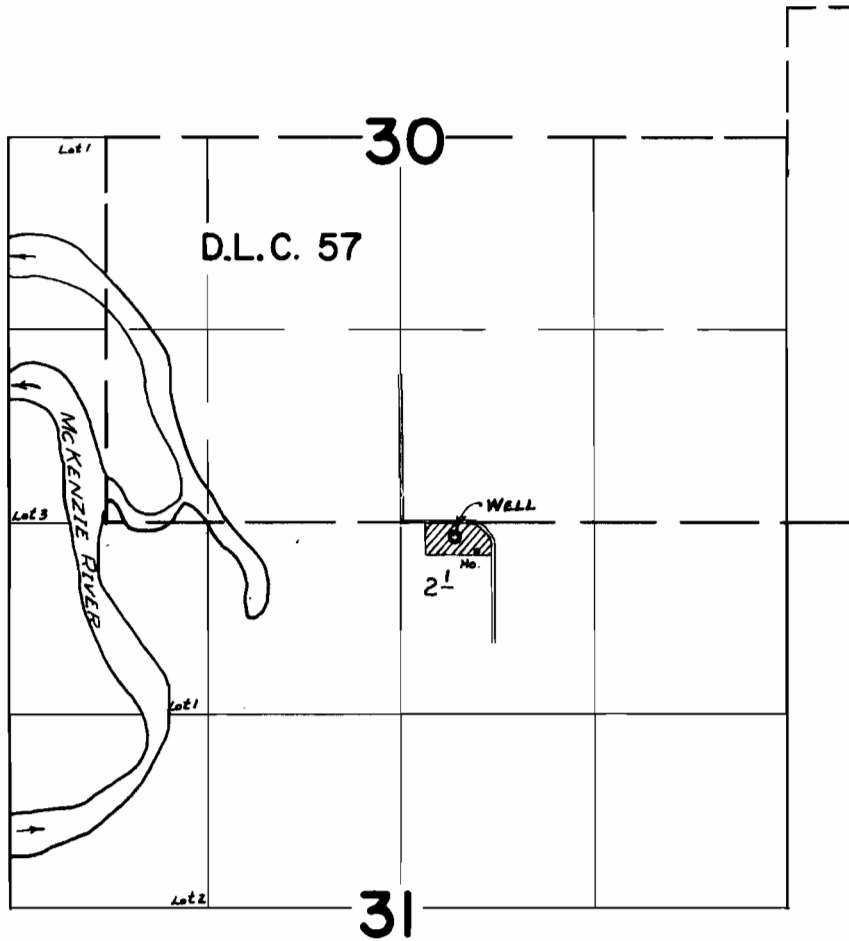

FINAL PROOF SURVEY
UNDER

Application No. G-1023 Permit No. G-903
IN NAME OF

DELMAR J. STORMENT

Surveyed 28 APRIL 1960, by M. Bish