


T.23S.R.1E.W.M.

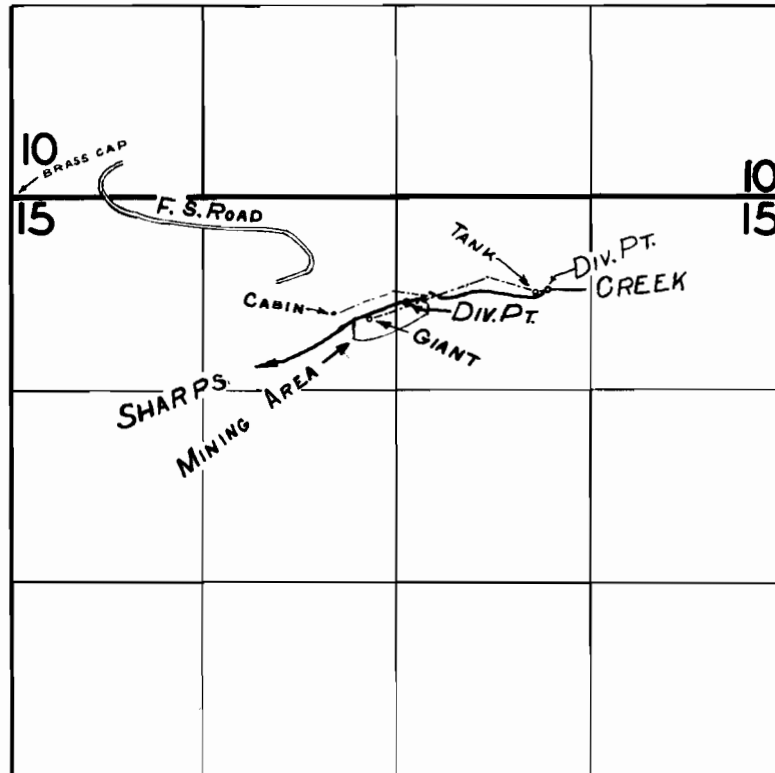

FINAL PROOF SURVEY
UNDER

Application No. 25504. Permit No. 20038...
IN NAME OF

LANE MINERALS INC.

Surveyed *AUG 30* 1960, by *M. BISH*

1960 E

M.B.