


T.18S.R.2W.W.M.

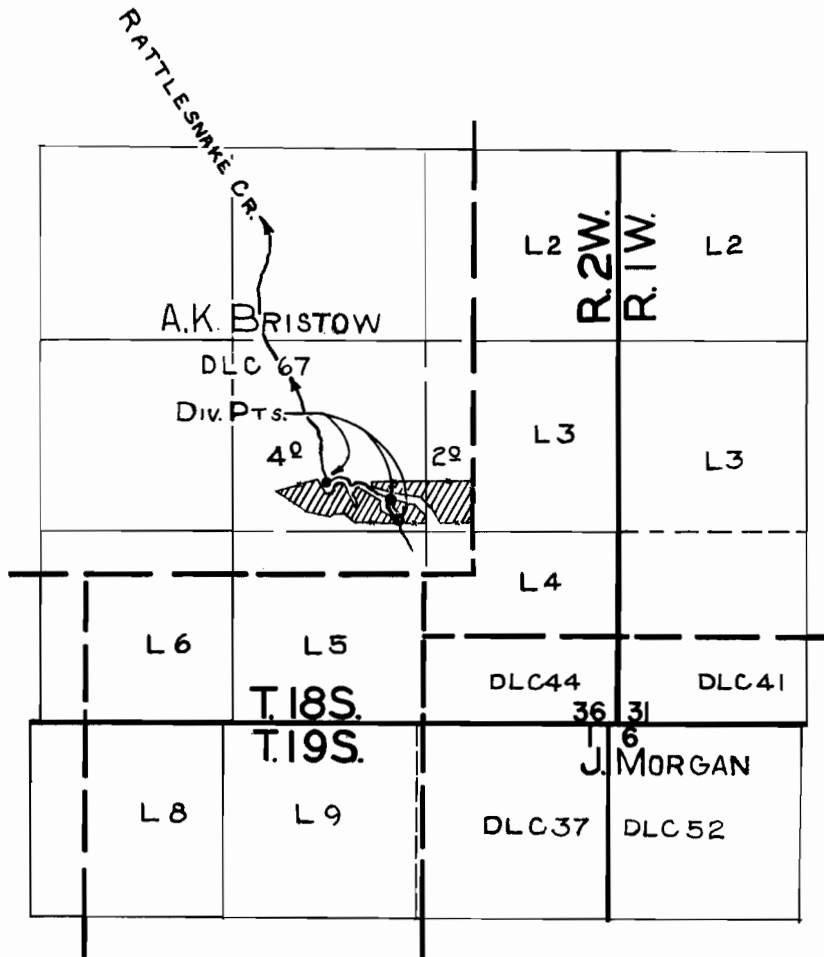

FINAL PROOF SURVEY UNDER

Application No. 25850 Permit No. 20302
IN NAME OF

..... FLOYD A. TAYLOR

Surveyed Aug 31, 1960, by M. BISH