


T.16S.R.4E.W.M.

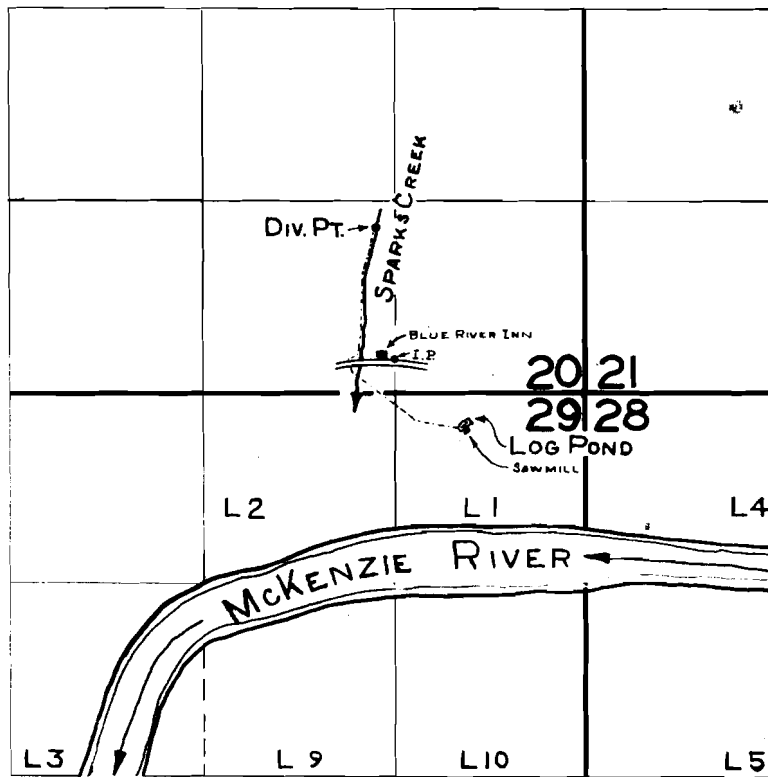

FINAL PROOF SURVEY
UNDER

Application No. ^{R-30222} 30323 Permit No. ^{R-1769} 23735
IN NAME OF

PHILLIP C. MCGOVERN

Surveyed SEPT 2 1960. by M. BISH