


T.16S.R. 4E.W.M.

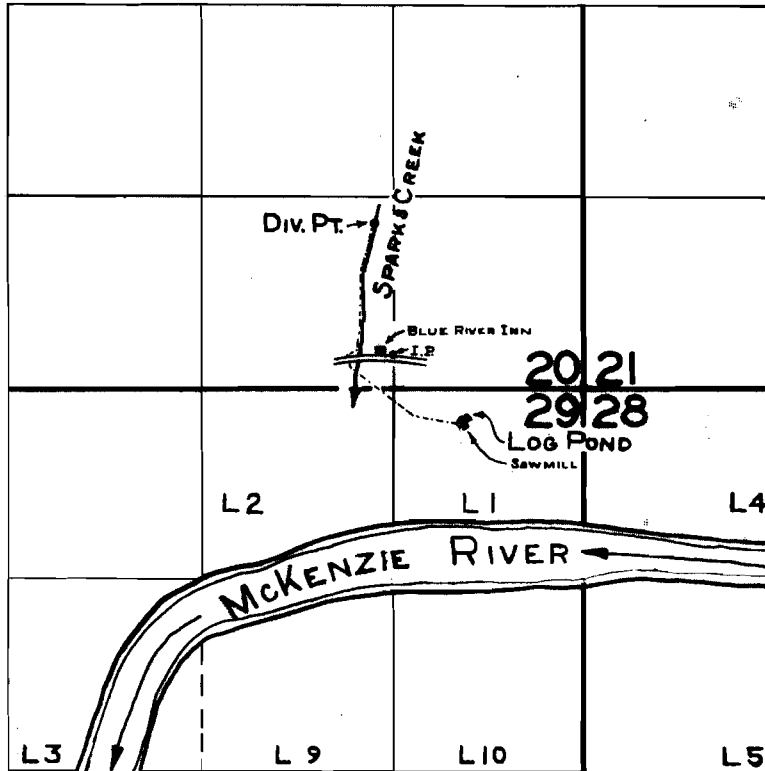

FINAL PROOF SURVEY UNDER

Application No. ^{R-30222}~~30323~~ Permit No. ^{R-1769}~~23735~~
IN NAME OF

.....**PHILLIP C. MCGOVERN**.....

Surveyed SEPT. 2 1960, by M. BISH.....