


# T. 17S. R. 2W. W.M.

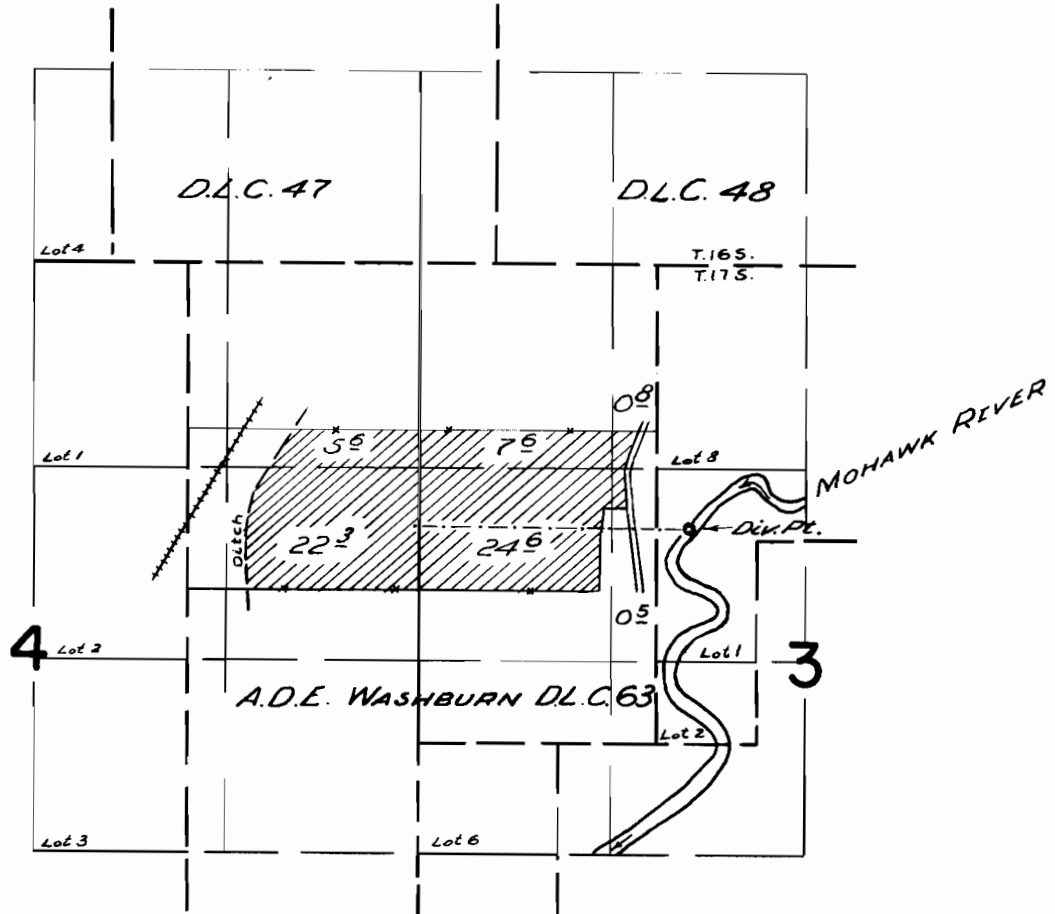

## FINAL PROOF SURVEY UNDER

Application No. 30950. Permit No. 24349  
IN NAME OF

KENNETH E. BEDORTHA

Surveyed APRIL 29, 1960., by M. Bish