


T.18&19S. R.1&2W.W.M.

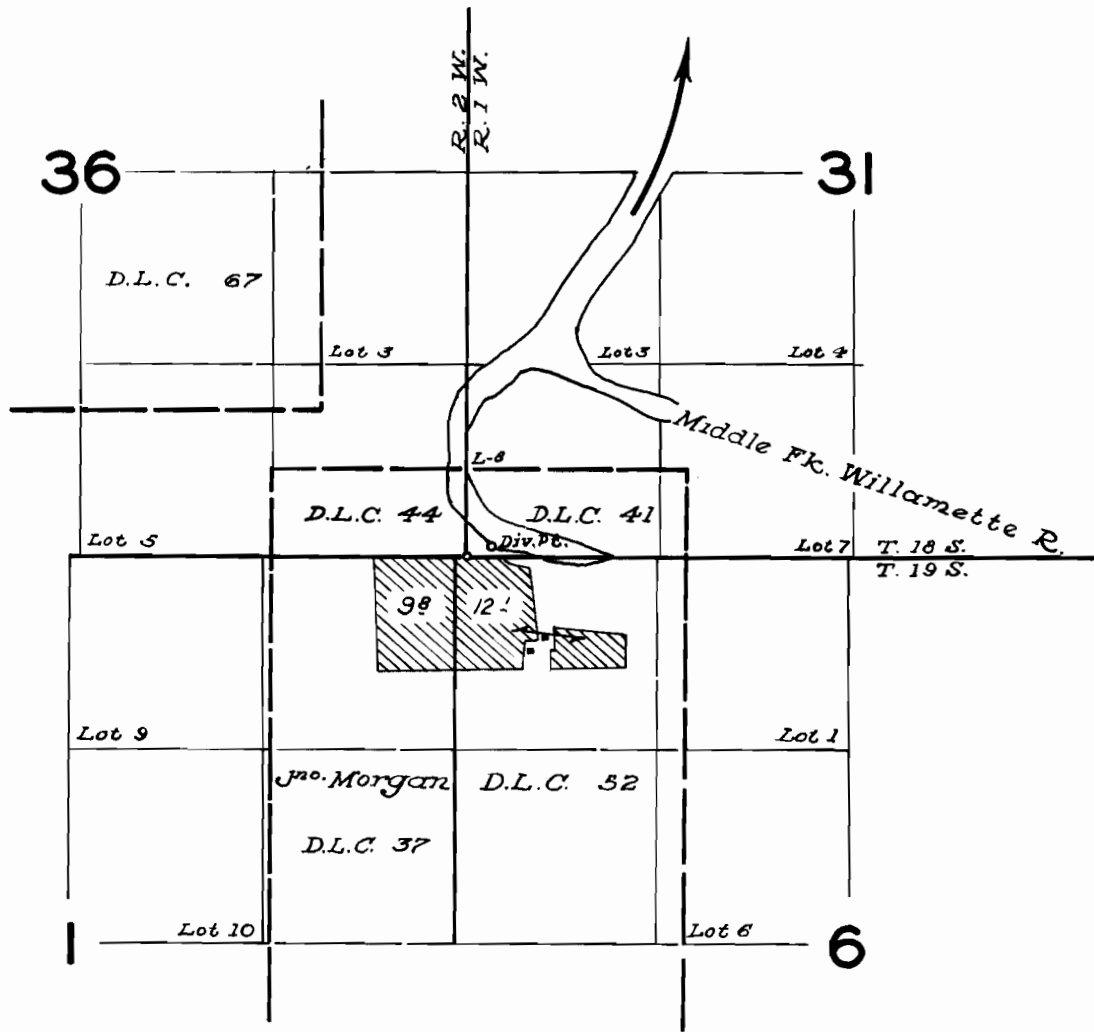

FINAL PROOF SURVEY
UNDER

Application No. 32583 Permit No. 25780.
IN NAME OF

BERT VAN DER WAAL

Surveyed May 9, 1960, by *D. Jackson*