


T. 17S.R.1W.W.M.

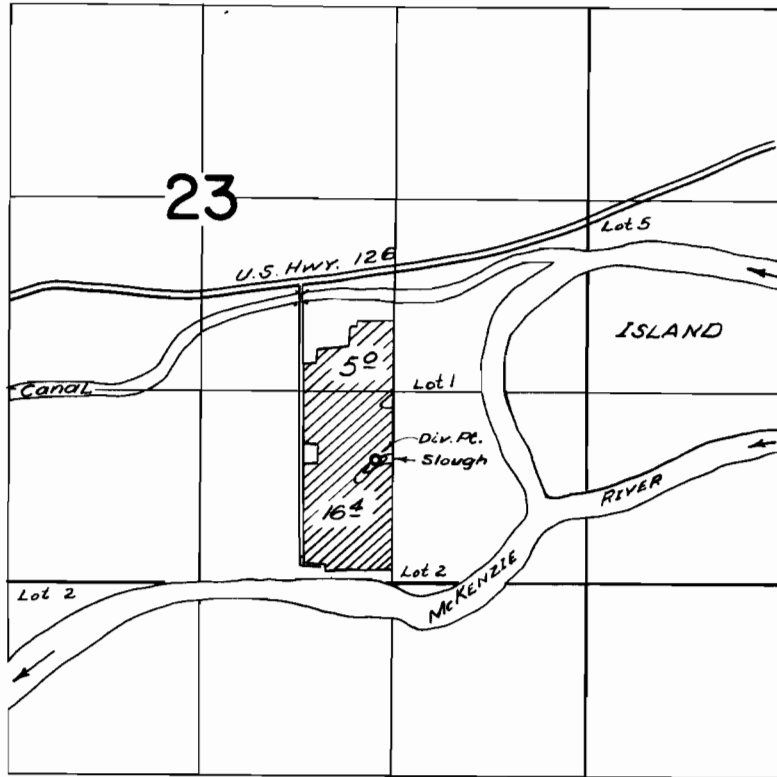

FINAL PROOF SURVEY
UNDER

Application No. 32524... Permit No. 25826...
IN NAME OF

BURT and SUSAN PARTRIDGE

Surveyed 5 MAY 1960, by *M. Bish*