


T.6S.R.10W.W.M.

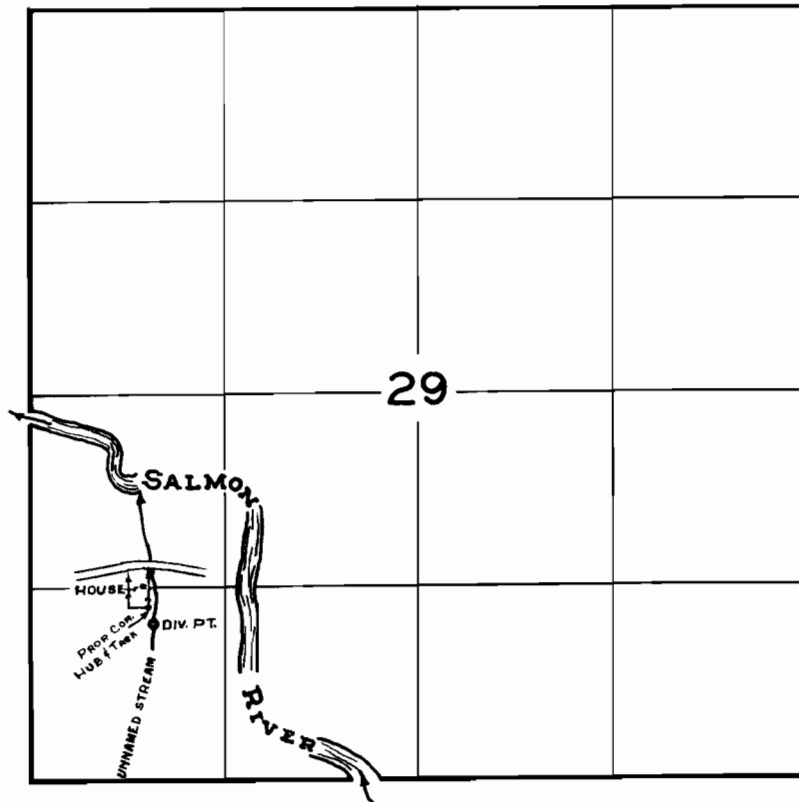

**FINAL PROOF SURVEY**  
UNDER

Application No. 23054 Permit No. 18414  
IN NAME OF

W.W. Wood

Surveyed Aug 9 1960 by M. BISH