


T. 9 S. R. 10 W. W. M.

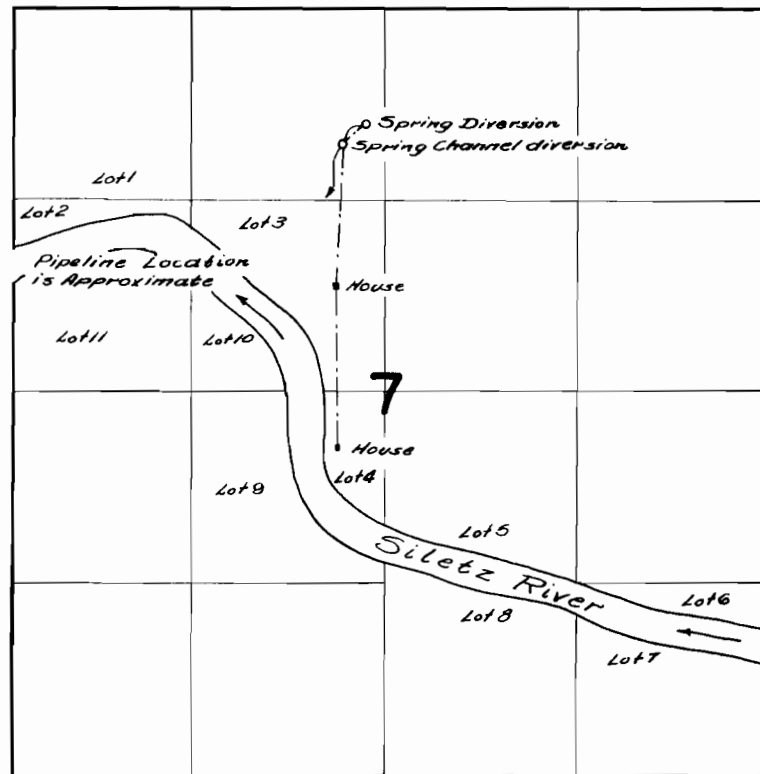

**FINAL PROOF SURVEY**  
UNDER

Application No. 29639... Permit No. 23216...  
IN NAME OF

*Ernest C. Parker, H.A. Hostetler*

Surveyed April 15, 1959, by *C.O. Baith*