


T.12S.R.8W.W.M.

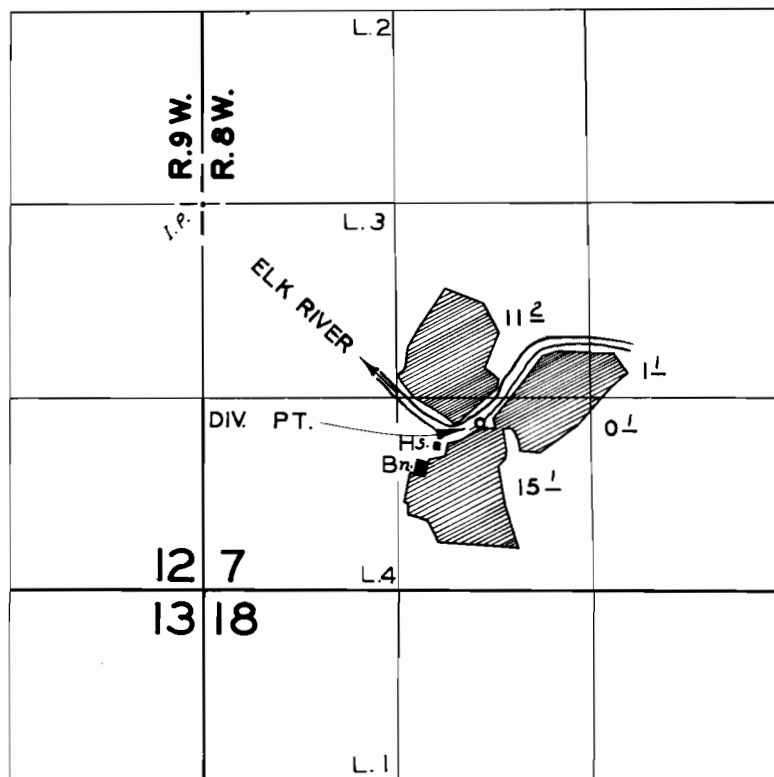

FINAL PROOF SURVEY
UNDER

Application No. 29720 Permit No. 23937
IN NAME OF

LEONARD T. GRANT

Surveyed AUG. 18, 1960, by

R. Jackson