


# TIIS.R.2W.W.M.

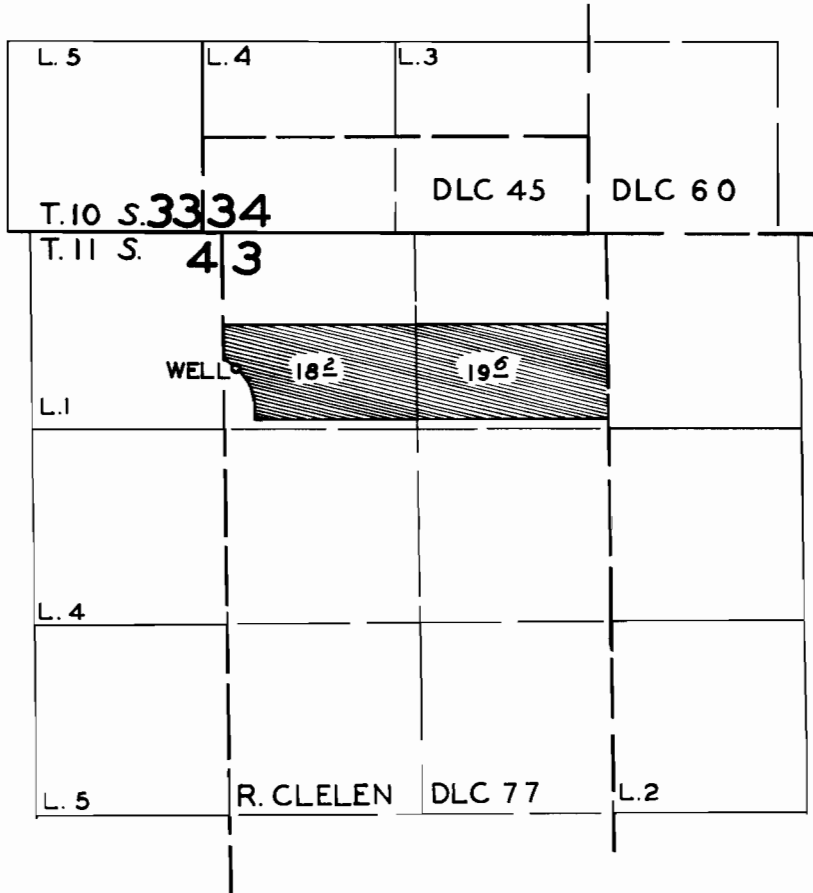

## FINAL PROOF SURVEY UNDER

Application No. G 626 Permit No. G 538  
IN NAME OF

SAM & OPAL LOONEY

Surveyed OCT. 13, 1960, by R. H. JACKSON