


T.9S. R.2E.W.M.

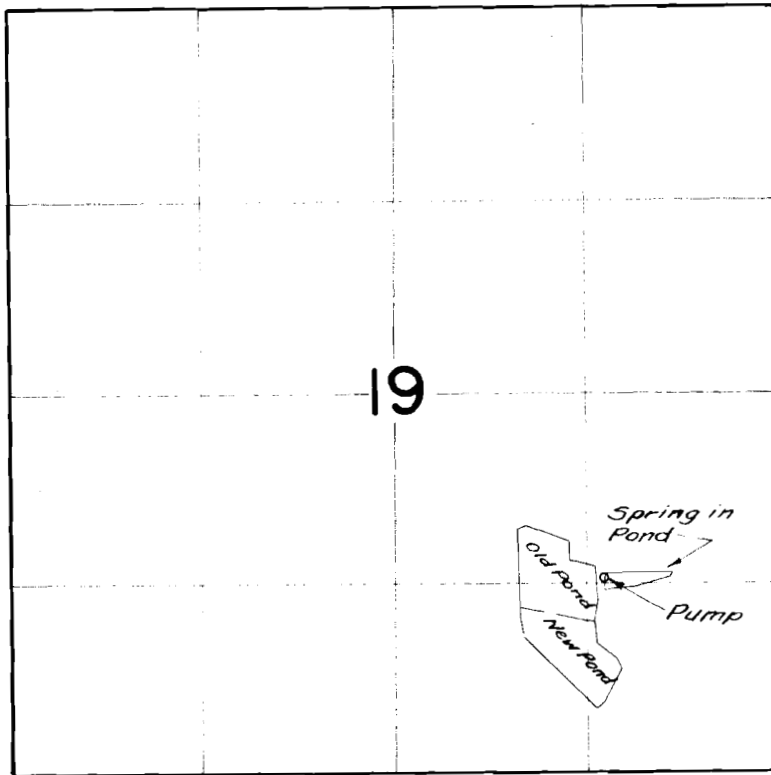

FINAL PROOF SURVEY
UNDER

R-22540 R-947
Application No. 22294 Permit No. 18291
IN NAME OF

Freres Lumber Co.

Surveyed June 1, 1960, by C.O. Bartels