


T.13 S.R.1 E.W.M.

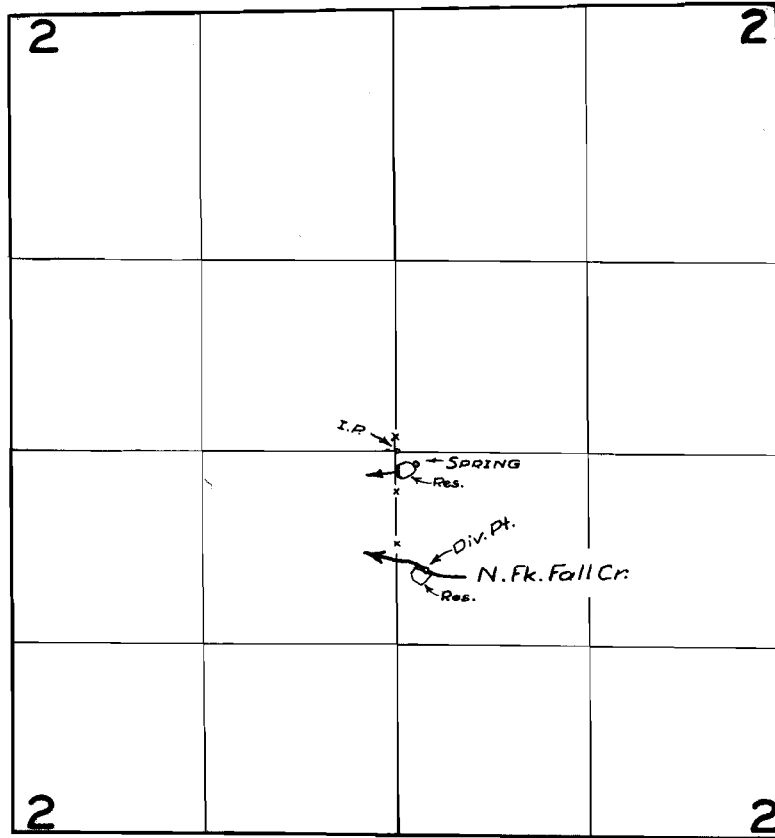

FINAL PROOF SURVEY UNDER

Application No. D-26701 Permit No. R-1291
IN NAME OF

EVERETT O. & LENA E. WATTERS

Surveyed 11 MAY 1960 by Mr. Bish