


T. 14 S. R. 2 W. W.M.

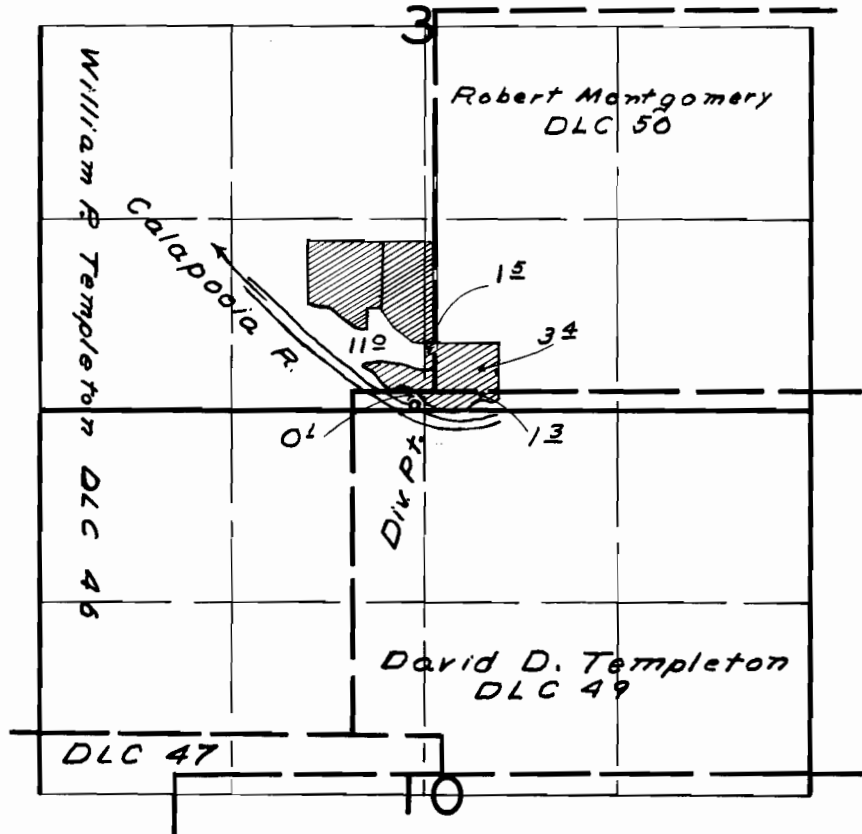

**FINAL PROOF SURVEY**  
UNDER

Application No. 27233 Permit No. 21427  
IN NAME OF

*Edgar E. Lafayette, Jr.*

Surveyed <sup>MAR. 31 1960</sup> ~~Sept. 12 1958~~ by <sup>M. Bish</sup> ~~W. N. Perry~~