


# T.13S. R.1 E.W.M.

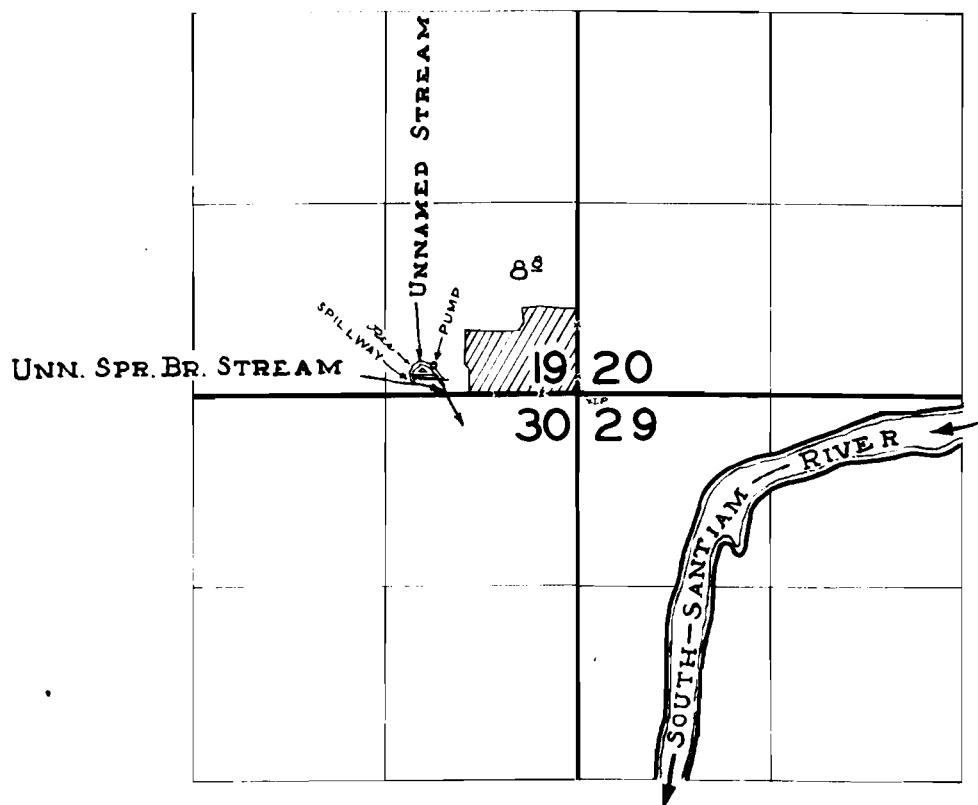

## FINAL PROOF SURVEY UNDER

29540 23751  
R 31748 R 2054  
Application No. 31749 Permit No. 25040  
IN NAME OF

RICHARD G. & MILLIE E. RELOUD

Surveyed MAY 12 1960, by M. BISH