


T.13S. R.1 E.W.M.

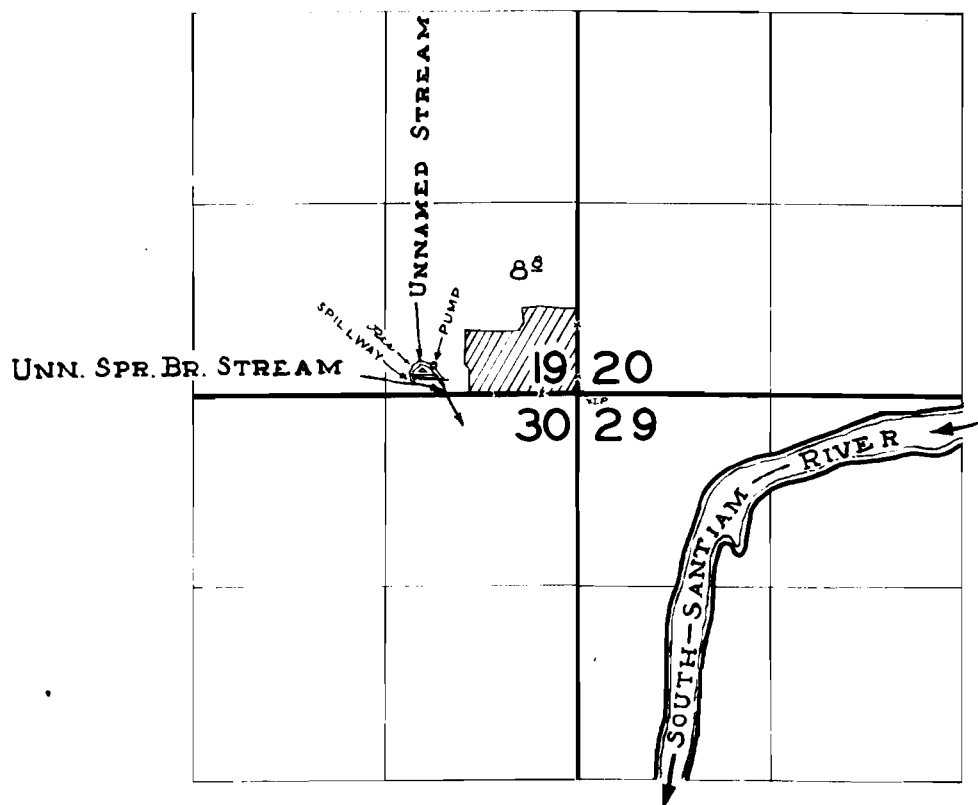

FINAL PROOF SURVEY UNDER

29540 23751
R 31748 R 2054
Application No. 31749 Permit No. 25040
IN NAME OF

RICHARD G. & MILLIE E. RELOUD

Surveyed MAY 12 1960, by M. BISH