


T.9S.R. IW.W.M.

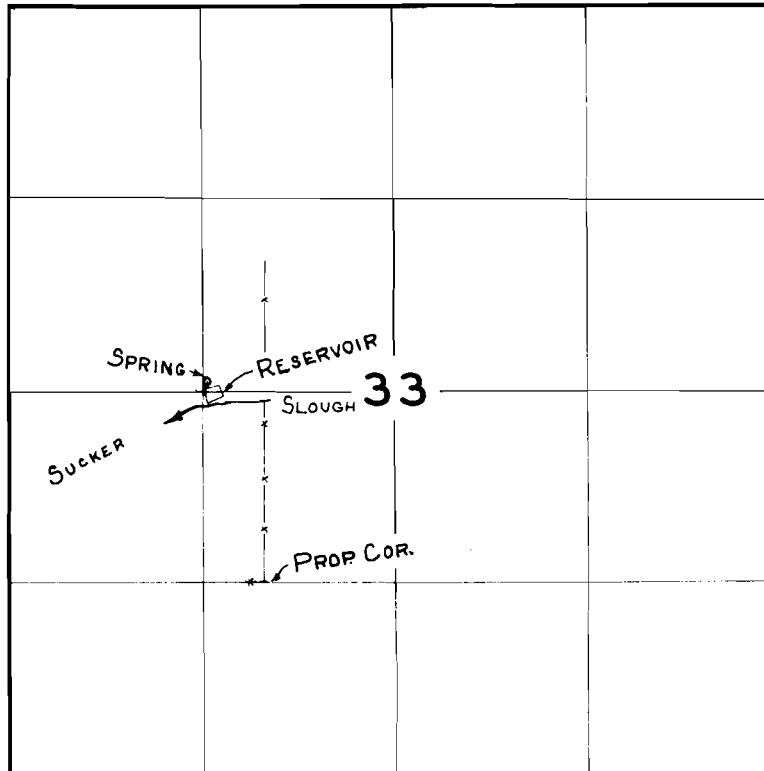

FINAL PROOF SURVEY
UNDER

Application No. R-33423 33424 Permit No. R-2290 26426
IN NAME OF

GEORGE SILBERNAGEL

Surveyed JULY 6 1960, by M. BISH

1960-D