


# T.29 S.R.44 E.W.M.

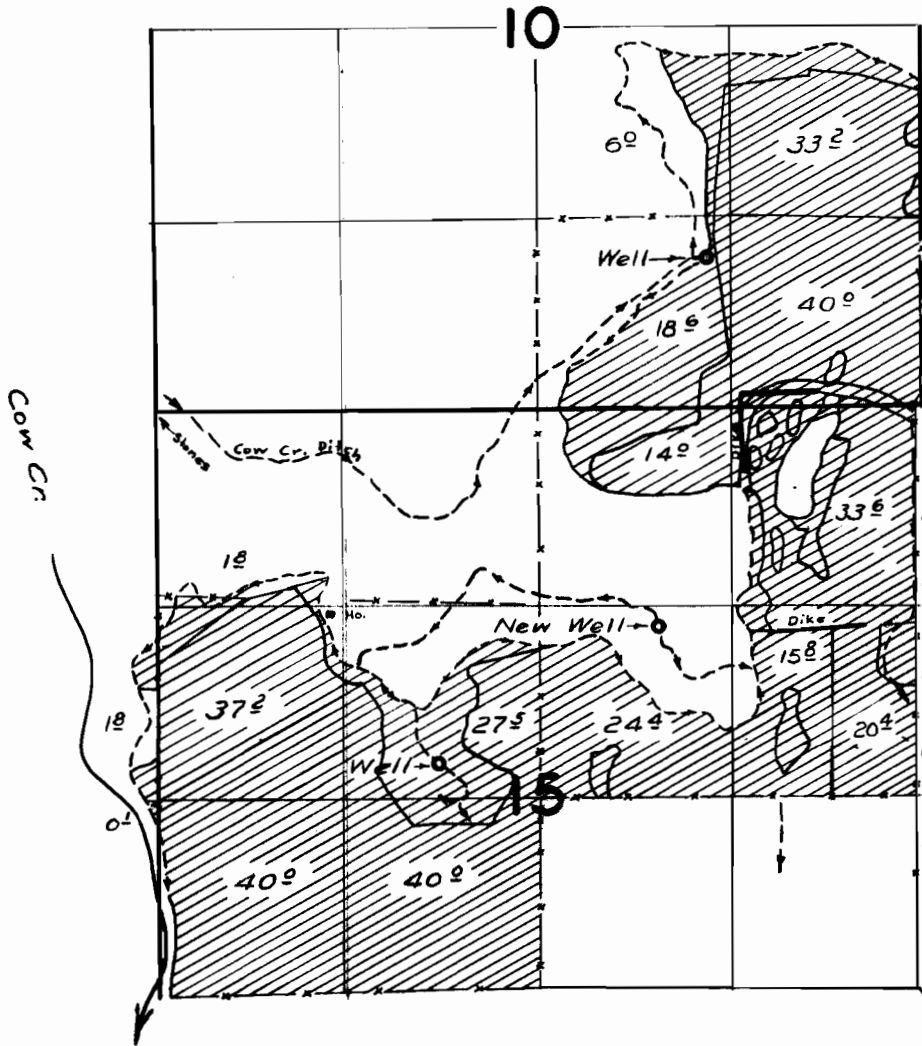

## FINAL PROOF SURVEY

UNDER

Application No. U-582 Permit No. U-511

IN NAME OF

IRIS G. ANAWALT

Surveyed 24 Sept. 1959, by M. Bish