


T.18 S.R.46 E.W.M.

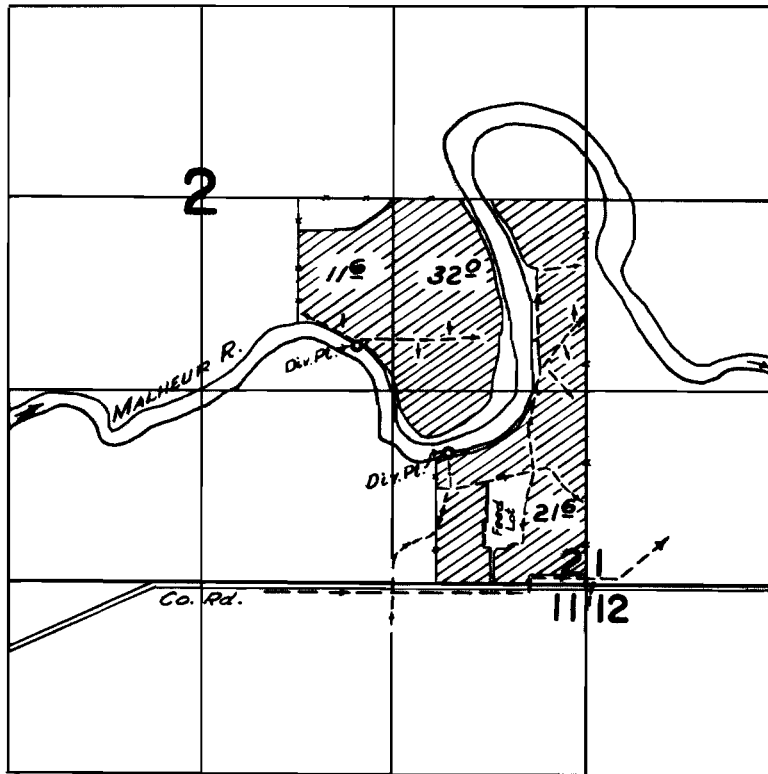

FINAL PROOF SURVEY
UNDER

Application No. 30152 Permit No. 23790
IN NAME OF

CLARENCE WELTY

Surveyed 27 Oct. 1960, by Mr. Bish