


T.18S.R.46E.W.M.

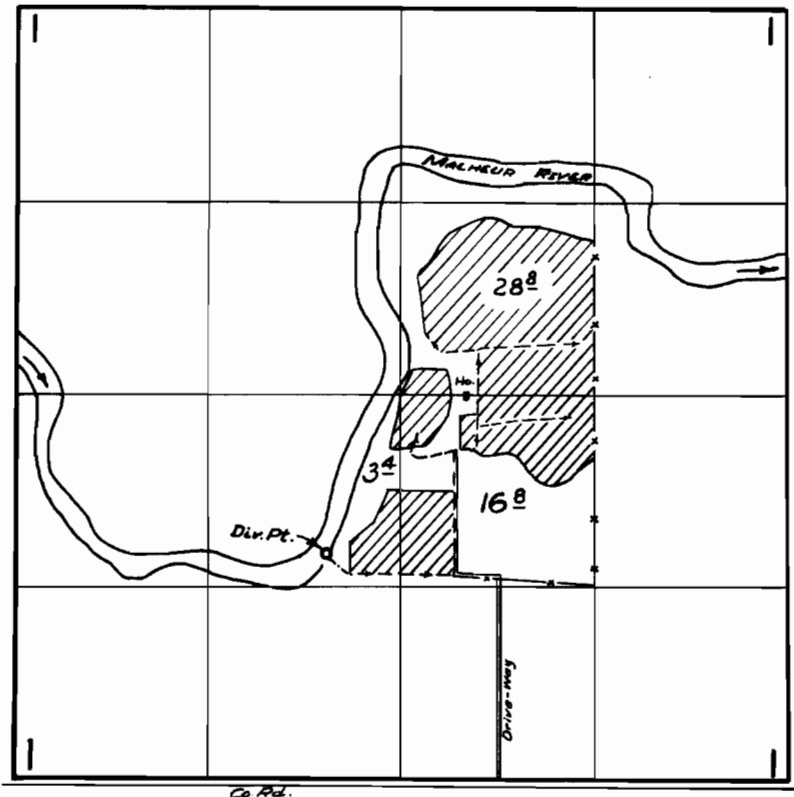

FINAL PROOF SURVEY
UNDER

Application No. 30593 Permit No. 24113
IN NAME OF

TOM N. NAKANO

Surveyed 28 Oct. 1960, by Mr. Bid