


T.10S. R.5W.W.M.

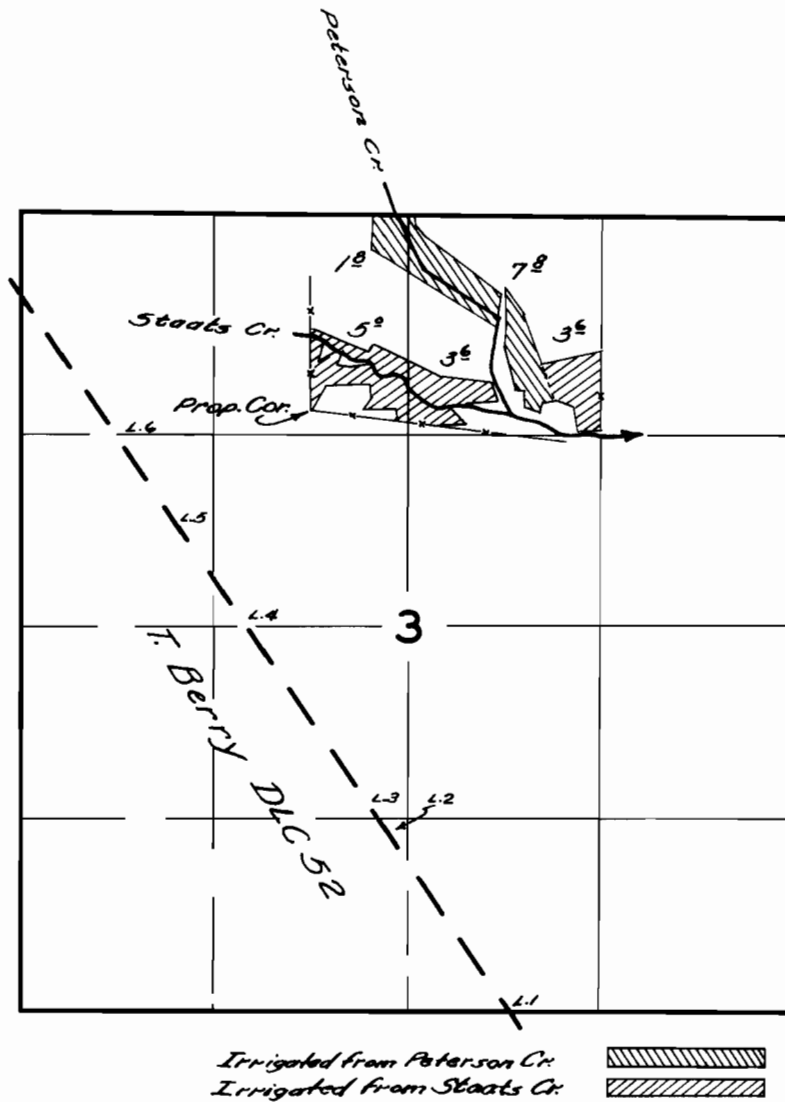

FINAL PROOF SURVEY
UNDER

Application No. 26081 Permit No. 20395
IN NAME OF

Warren J. Buckovic

Surveyed Oct. 14, 1960, by C. O. Bartels