


T. 7 S. R. 4 W. W. M.

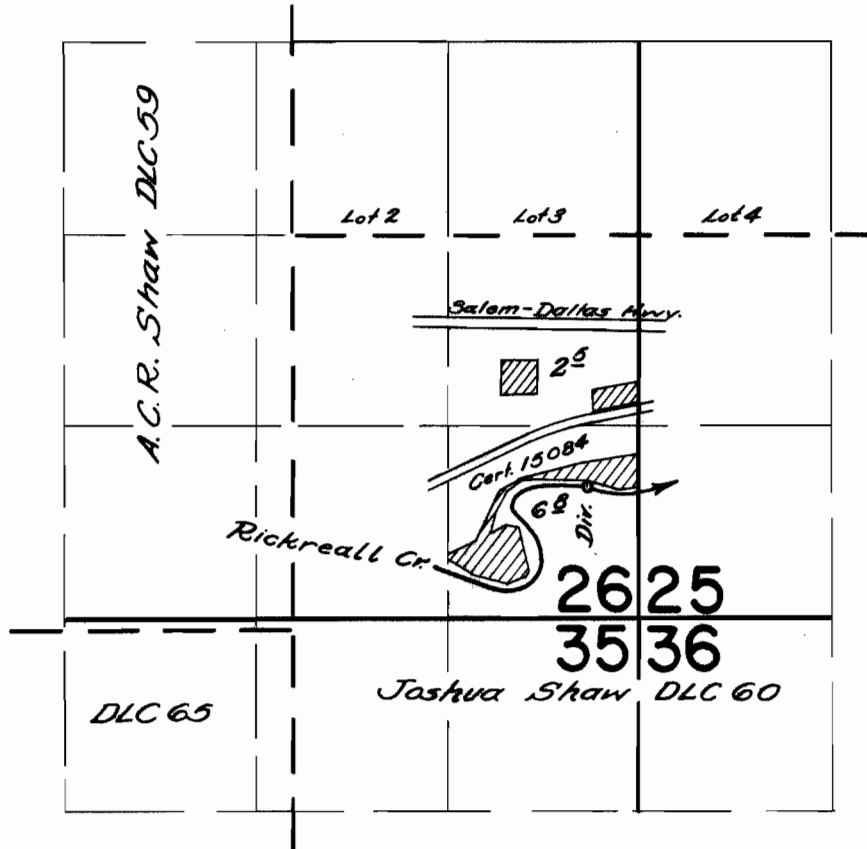

**FINAL PROOF SURVEY**  
UNDER

Application No. 33136 Permit No. 26205  
IN NAME OF

JACK R. ALLM

Surveyed Oct. 14, 1960, by CB Baile