


T. 4 & 5 N. R. 28 E. W. M.

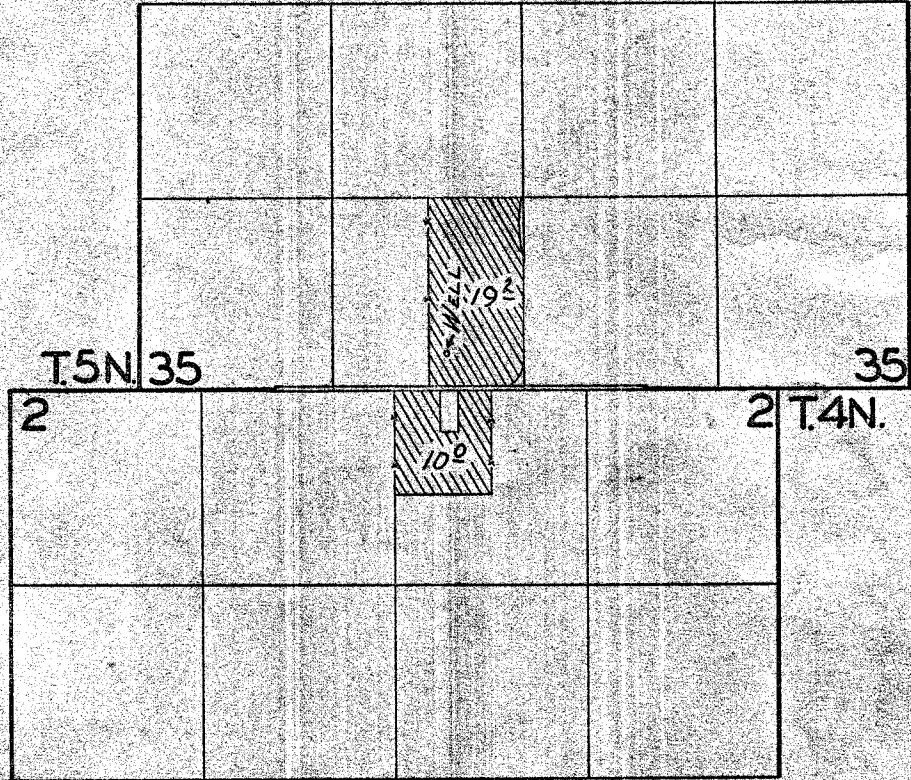

FINAL PROOF SURVEY UNDER

Application No. *G. 199*..... Permit No. *G. 110*.....
IN NAME OF

RUBY V. WELCH

Surveyed *JULY 23 1960*, by *M. BISH*.....