


T.4N.R.34E.W.M.

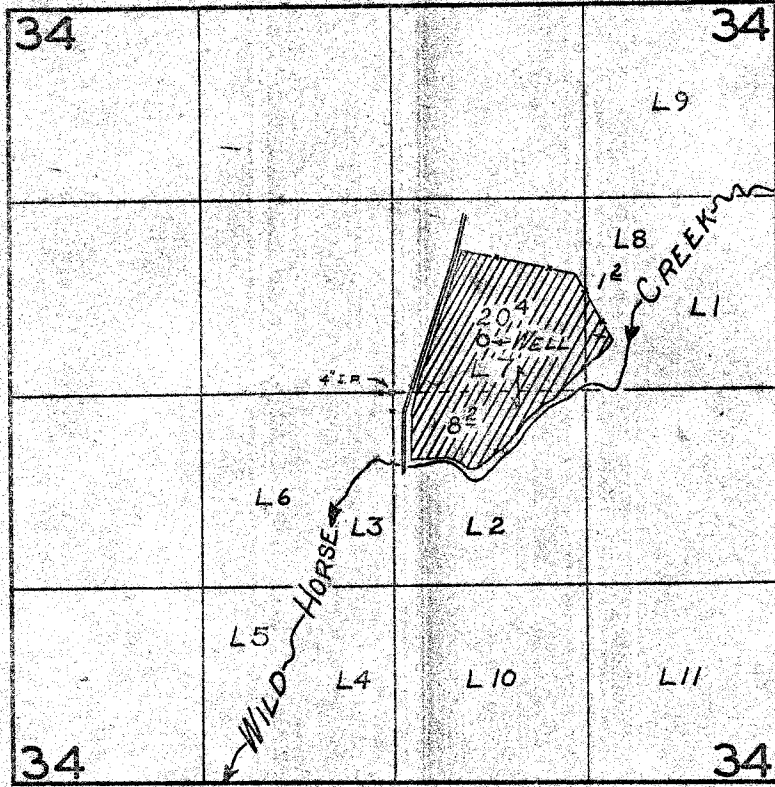

FINAL PROOF SURVEY UNDER

Application No. G-373. Permit No. G-249...
IN NAME OF

R. L. & EDITH R. LIEVALLEN

Surveyed JULY 22 1960, by M. BISH

May 22, 1952

AK