


T.6N.R.33E.W.M.

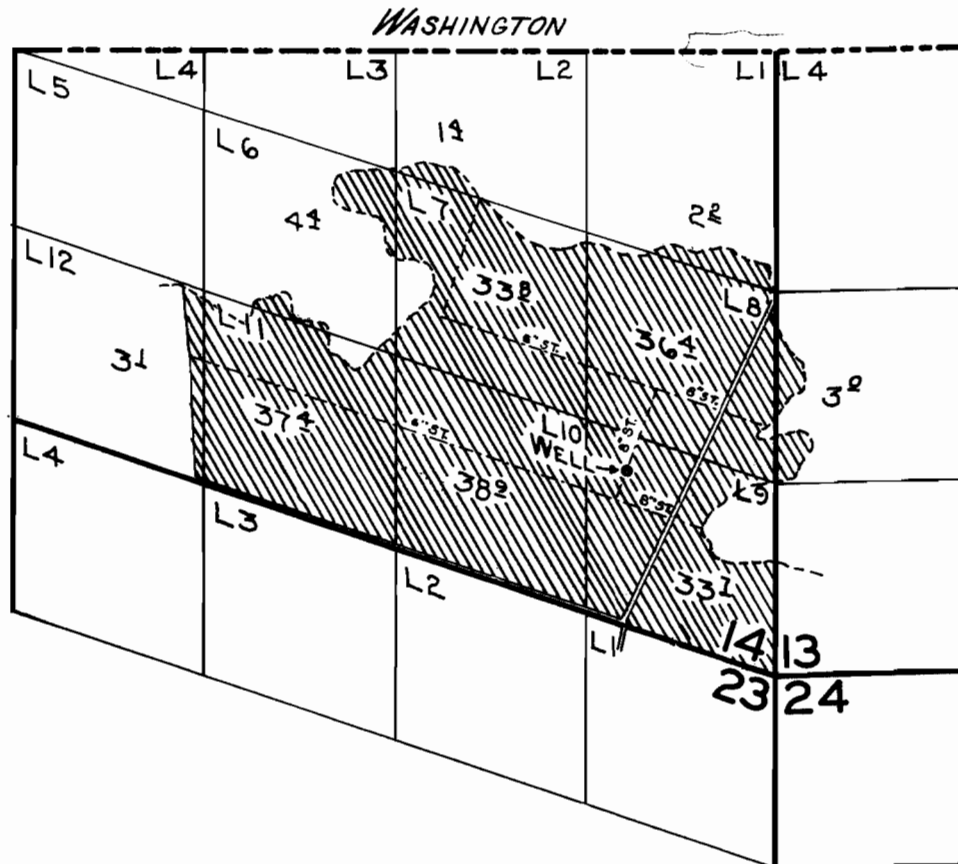

FINAL PROOF SURVEY UNDER

Application No. *G-367*... Permit No. *G-302*...
IN NAME OF

.....*E.C. BURLINGAME JR.*.....

Surveyed *JULY 20, 1960*, by *M. BISH*.....

1960-D
NZ-5F-114

RB.