


T.6N.R.35E.W.M.

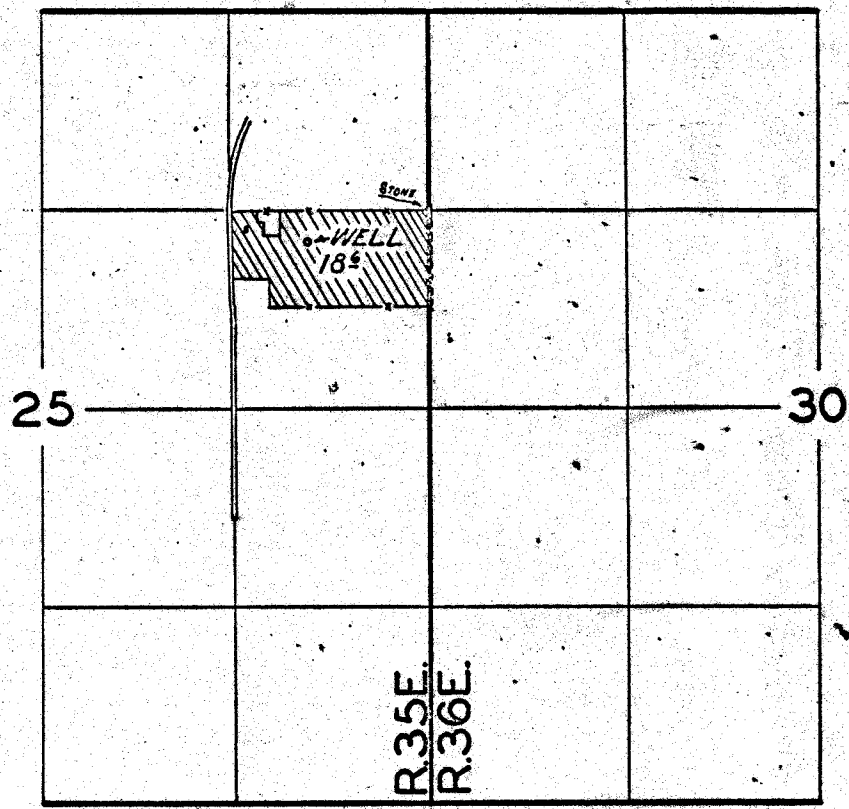

FINAL PROOF SURVEY UNDER

Application No. 262 Permit No. 2712
IN NAME OF

HENRY C. STEWART

Surveyed JULY 13, 1960, by M. BISH