


T. IN. R. 32E.W.M.

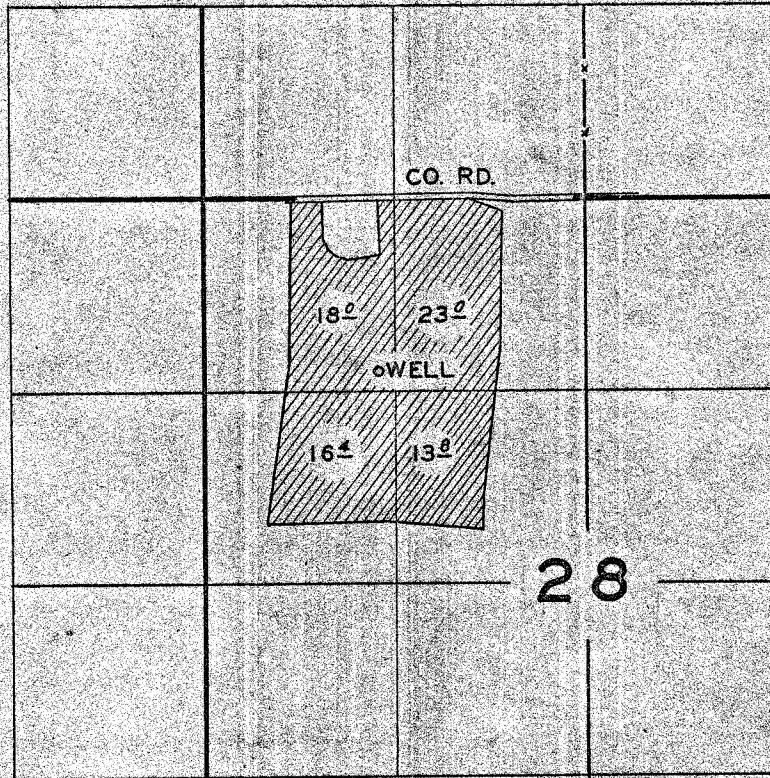

FINAL PROOF SURVEY UNDER

Application No. G 556 Permit No. G 471
IN NAME OF

EDWIN HOEFT

Surveyed JULY 13 1960, by [Signature]