


G-481
48308
28728

T.4N.R.29E.W.M.

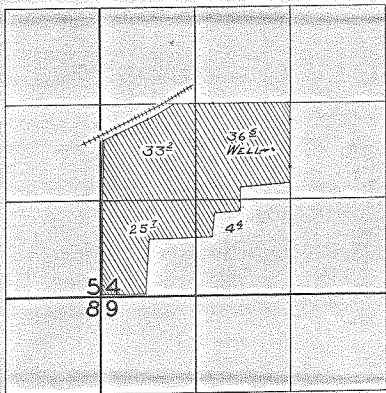

FINAL PROOF SURVEY UNDER

Application No. G-566 Permit No. G-481
IN NAME OF

JOHN F. WALCHLI

Surveyed Nov. 17, 1962, by M. BISH

NZ 9F 46
NZ 1P 127