


T.6N.R.34E.W.M.

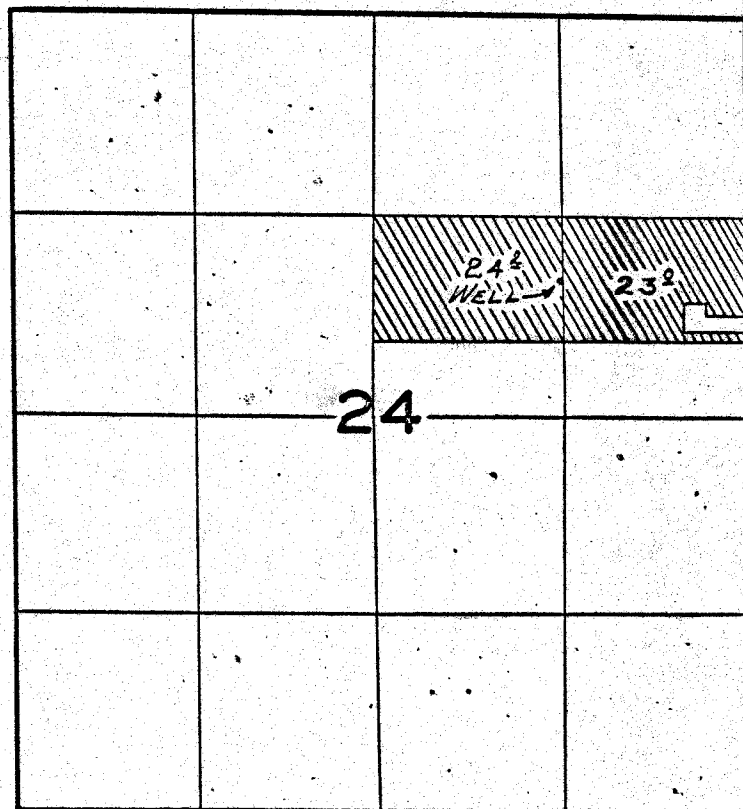

FINAL PROOF SURVEY UNDER

Application No. G-921 Permit No. G-805
IN NAME OF

JOHN T. RICHARTZ

Surveyed JULY 16, 1960, by M. BISH